


Application No 62751
Permit No. 46892

T295 R12W
Sec. 19
SW $\frac{1}{4}$

W ——— E

SCALE:
1" = 400'

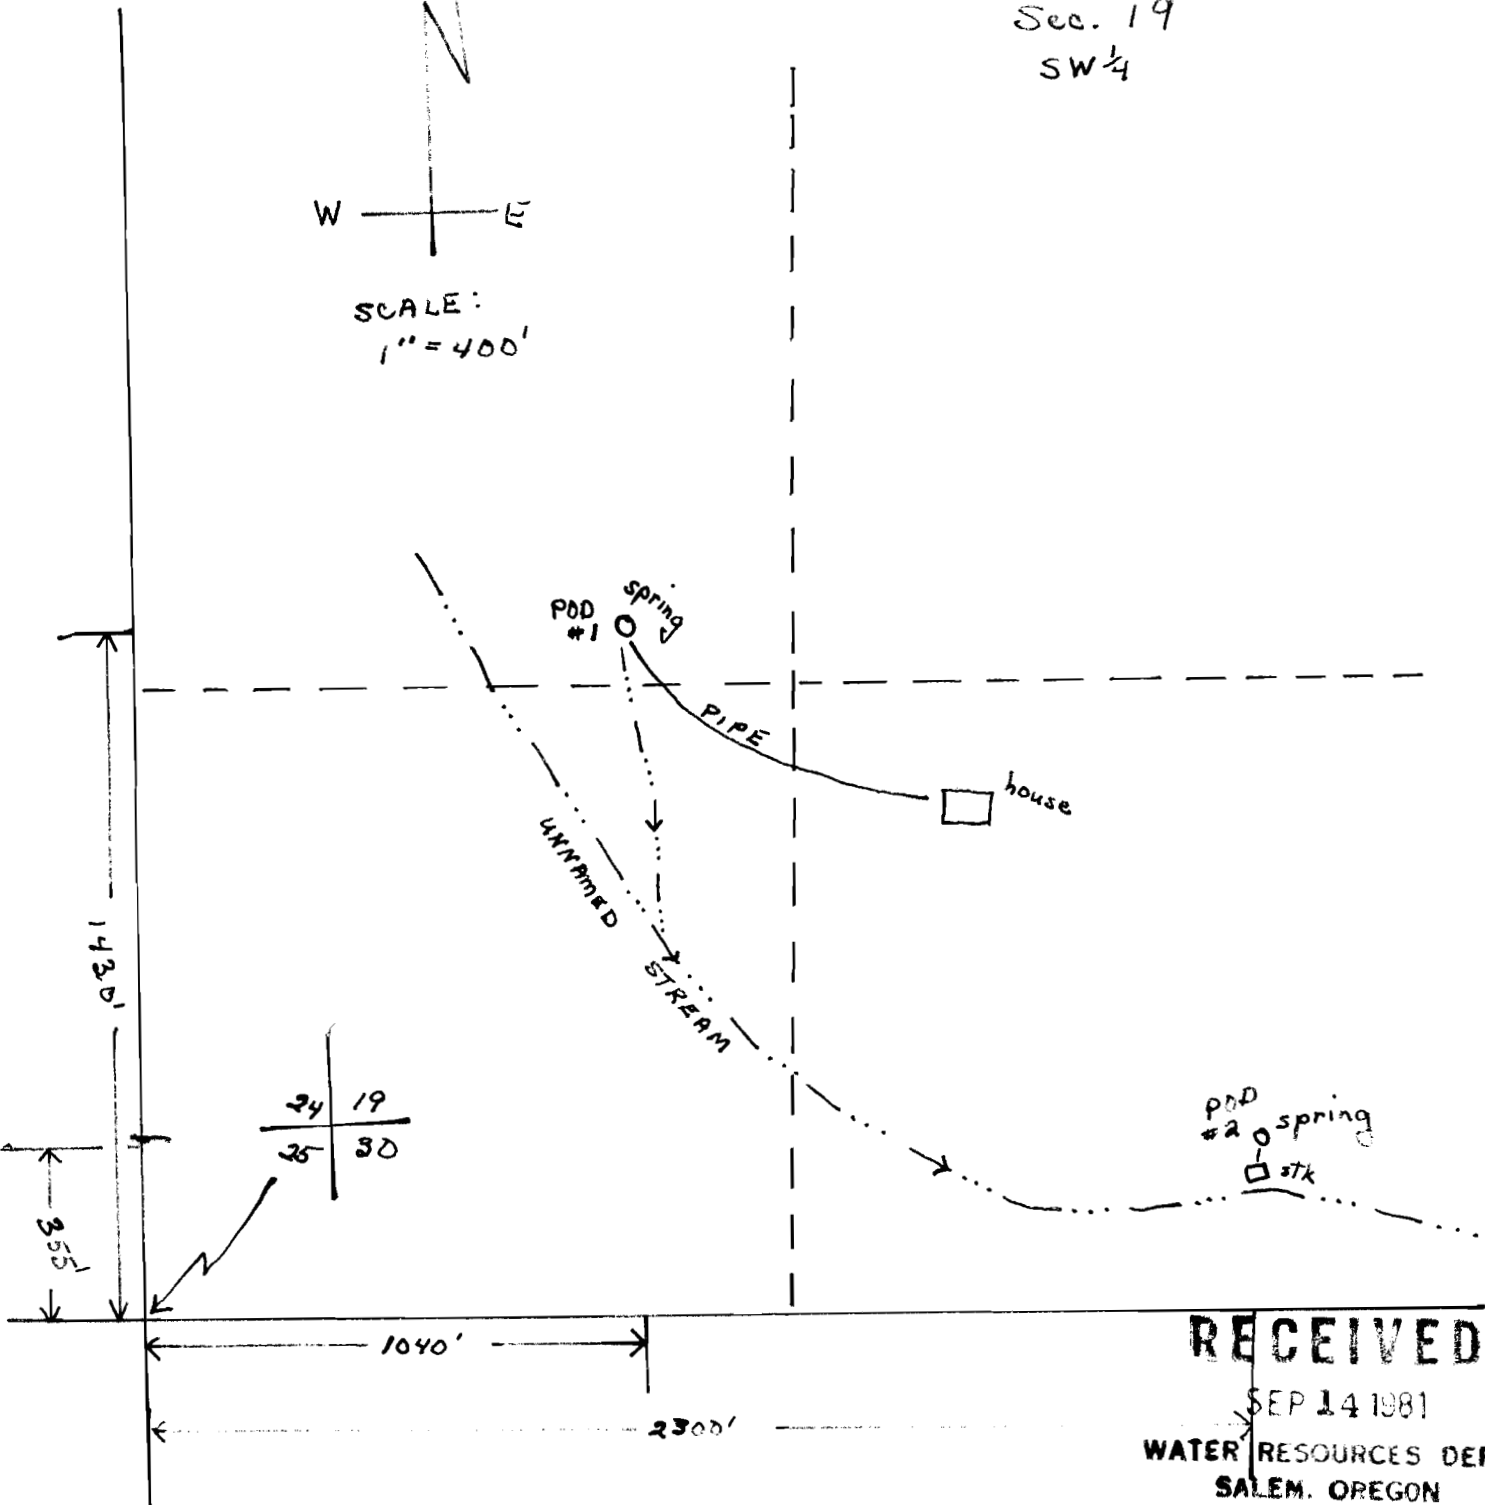

RECEIVED

SEP 14 1981

WATER RESOURCES DEPT
SALEM, OREGON