


SW 1/4 SECTION 34 T14S R12W WM
LINCOLN COUNTY

RECEIVED

MAR 16 1982

WATER RESOURCES DEPT.
SALEM, OREGON

Application No. 63409
Permit No. 42035

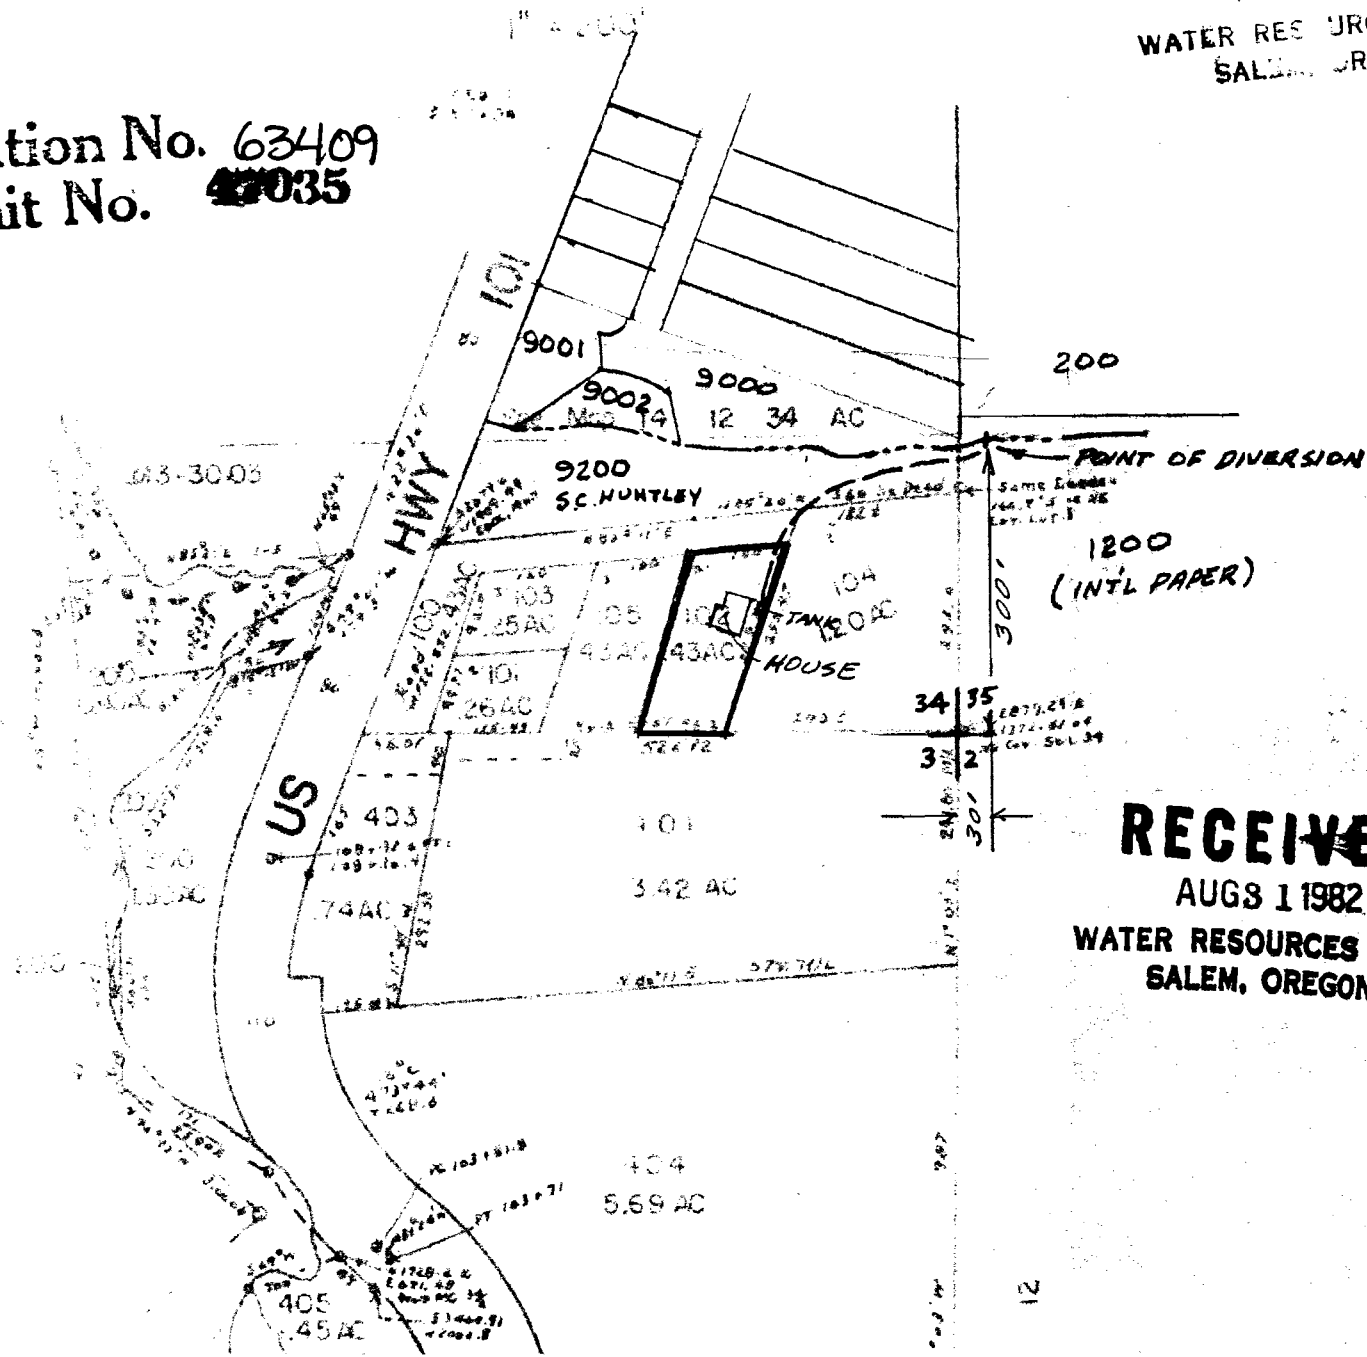

1200
(INTL PAPER)

RECEIVED

AUG 1 1982

WATER RESOURCES DEPT.
SALEM, OREGON

PACIFIC