


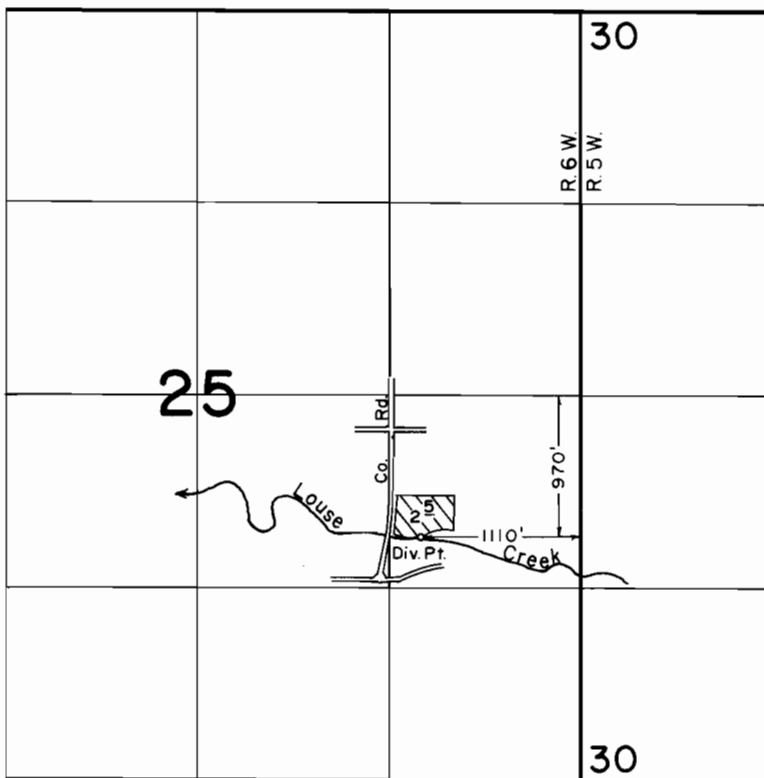

T. 35 S., R. 5 & 6 W., W.M.



SCALE: 1" = 1320'

**FINAL PROOF SURVEY**  
UNDER

Application No. 65480.. Permit No. 47962.....  
IN NAME OF

**THOMAS J. & SHIRLEY A. COSAERT**

Surveyed MAY 15... 1989, by B. S. JAMES.....