


T.16S., R.6W., W.M.

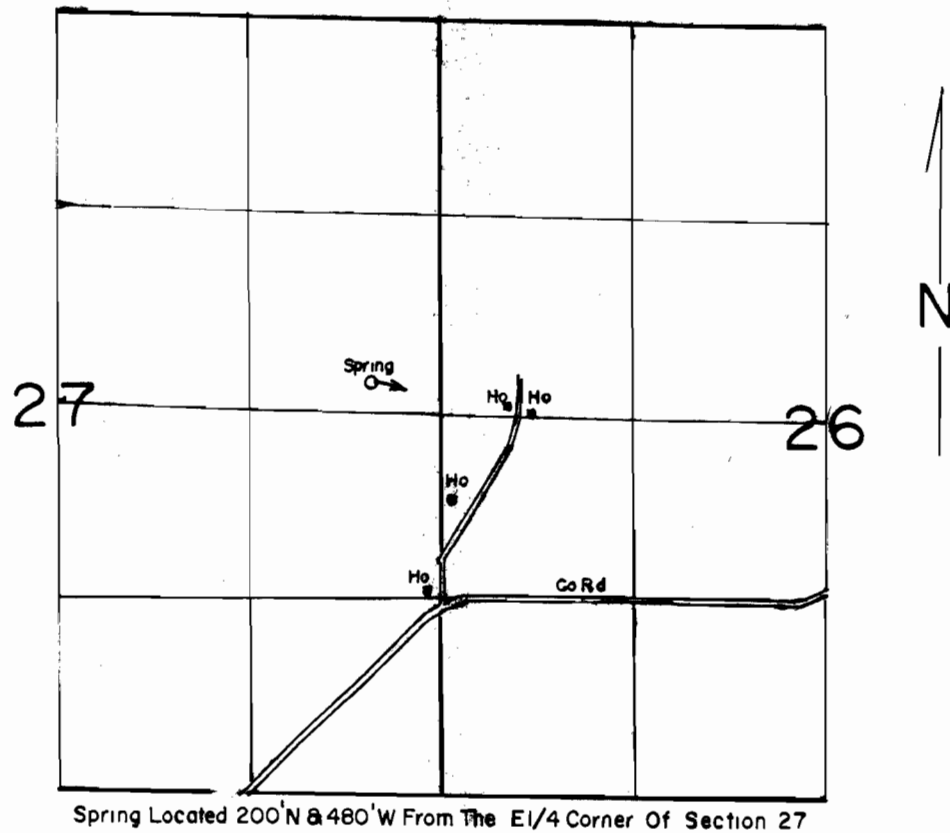

Spring Located 200' N & 480' W From The E1/4 Corner Of Section 27

SCALE: 1" = 1320'

FINAL PROOF SURVEY **UNDER**

Application No. 66017.. Permit No. 48291.....
IN NAME OF

.....SAM & HELEN.....BORLAND.....

Surveyed JUNE 13, 1990., by T.M. WARREN.....