


T. 6S., R. 37 & 38E., W. M.

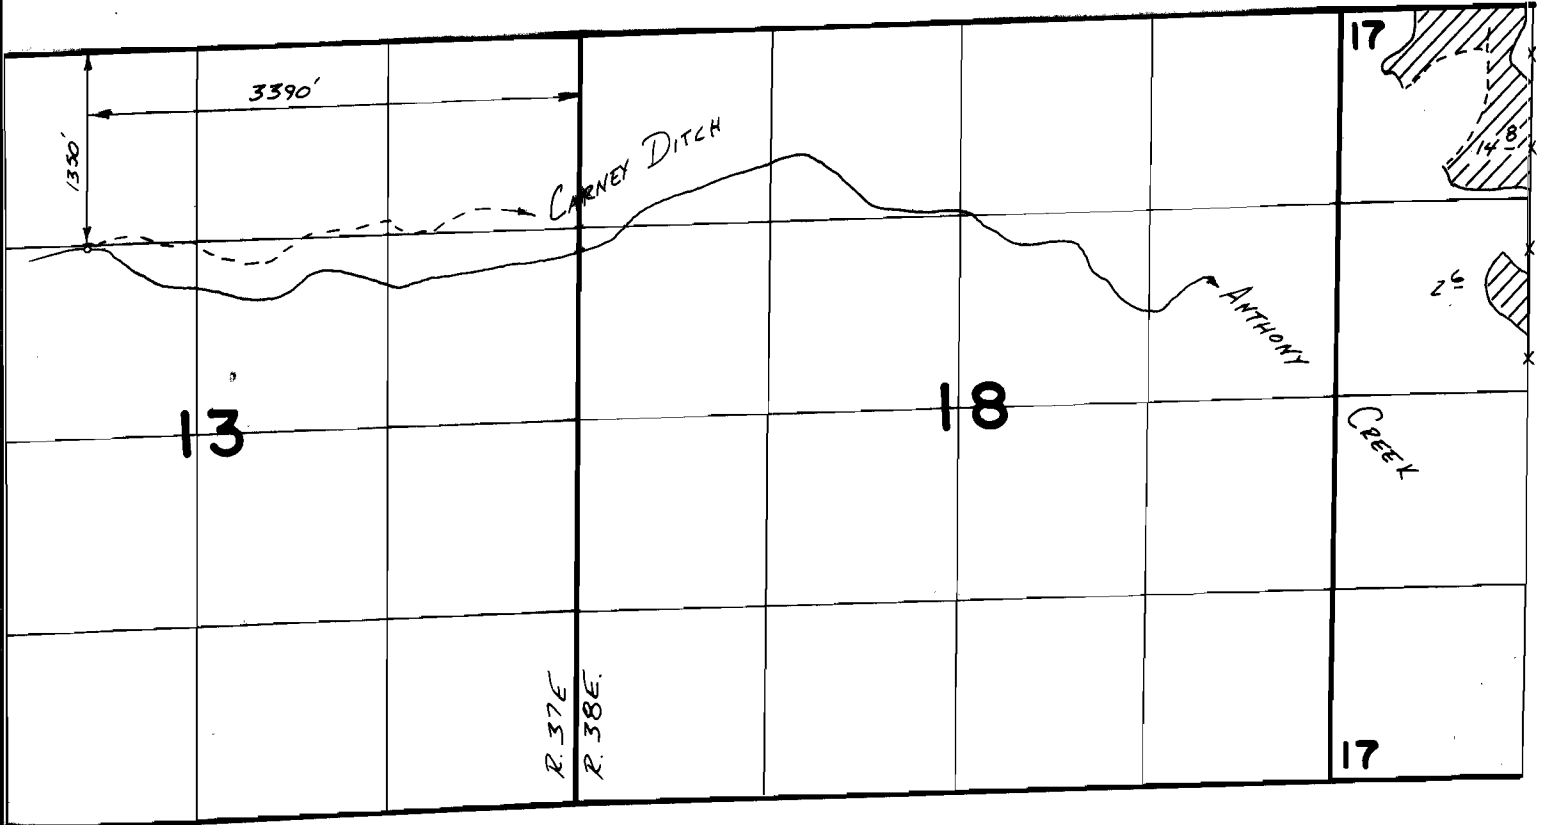


**FINAL PROOF SURVEY**  
UNDER

Application No. **67528** Permit No. **48507**  
IN NAME OF

.....**TOM HANLEY**.....

Surveyed **11-6** 19**88**, by **V.L. Church**.....

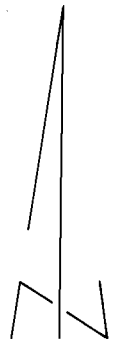

**SCALE 1"=1320'**