


# T. 4 S., R. 1 E., W. M.

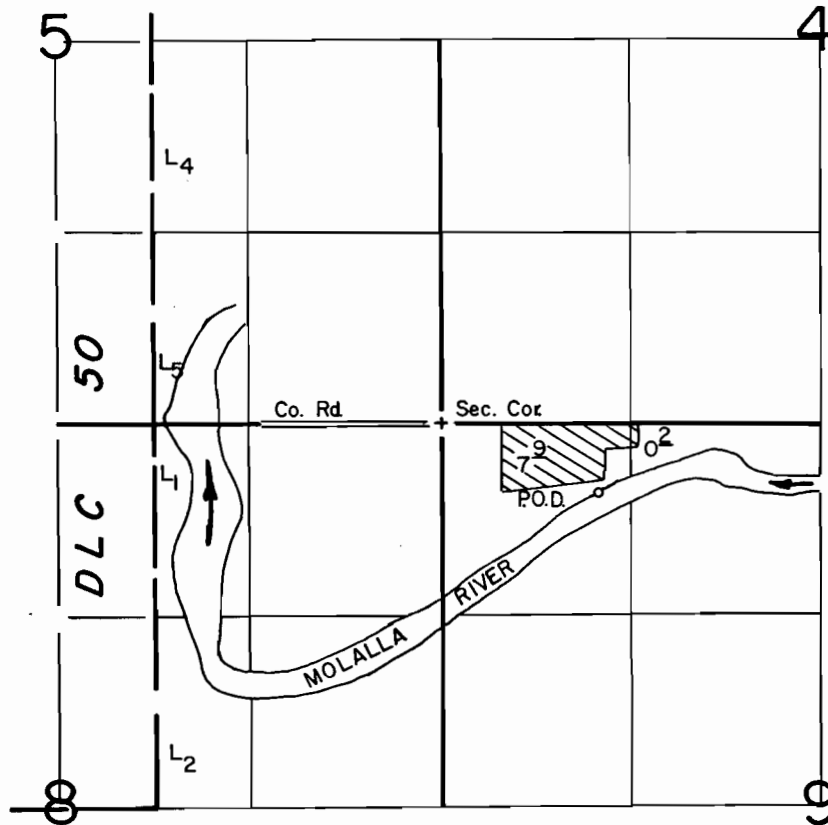

P.O.D. Loc. : 460' S. & 1070' E. from NW Cor. Sec. 9.

Scale: 1" = 1320'

## FINAL PROOF SURVEY UNDER

Application No. 68109... Permit No. 48681.....

IN NAME OF

**JAMES F & CAROL A. PIENOV**

Surveyed AUG. 7, 1989, by R. KLASSEN.....