


T. 7 S., R. 1 W., W.M.

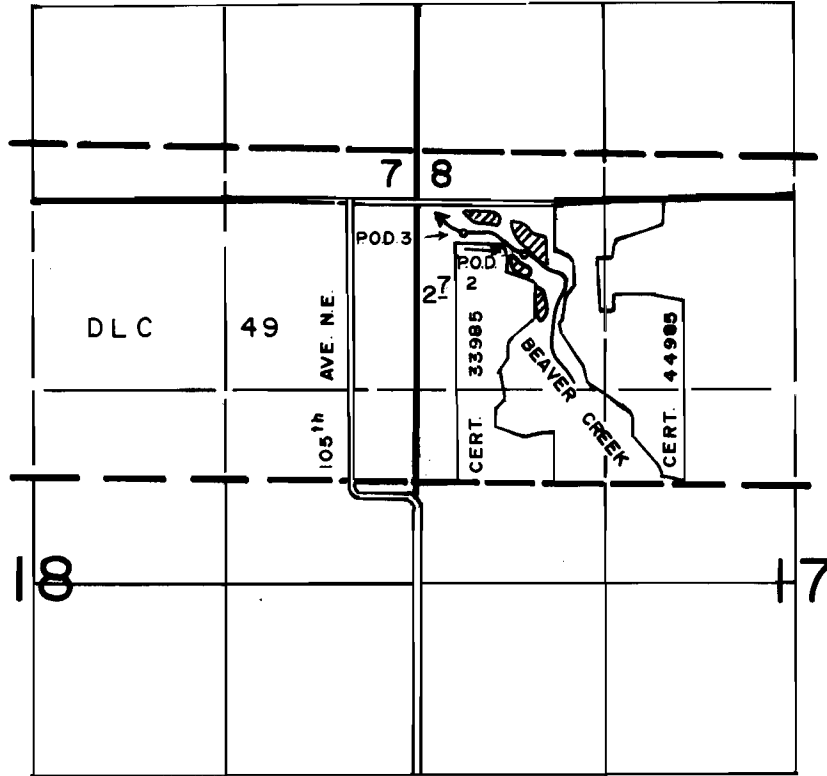

P.O.D. 2 340' S. @ 730' E. FROM NW CORNER SEC. 17  
P.O.D. 3 200' S. @ 330' E. FROM NW CORNER SEC. 17

1" = 1320'

### FINAL PROOF SURVEY UNDER

Application No. 68751... Permit No. 49718  
IN NAME OF

THEODORE F. SEEBER

Surveyed JULY 7 1990, by T.M. WARREN

8-7-90 DSM  
41047-278-1320