


T. 40 S., R. 14 W., W.M.

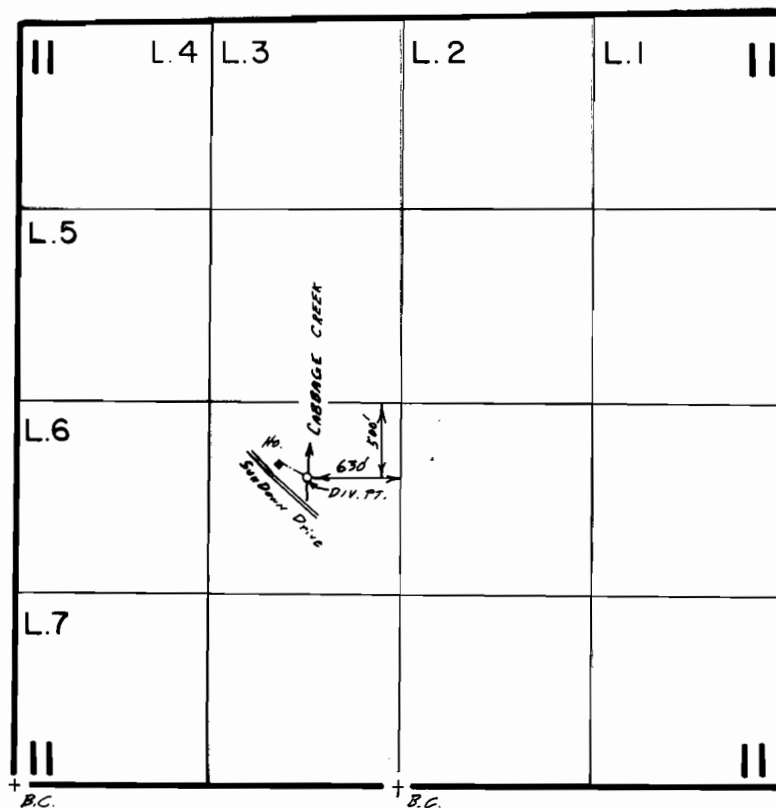

Scale 1"=1320'

FINAL PROOF SURVEY UNDER

Application No. 63958 Permit No. 47055
IN NAME OF

SAM G. ELLADES

Surveyed Sept. 2, 1987, by J.M. SCHMORDE