


T. I. S., R. I. E., W. M.

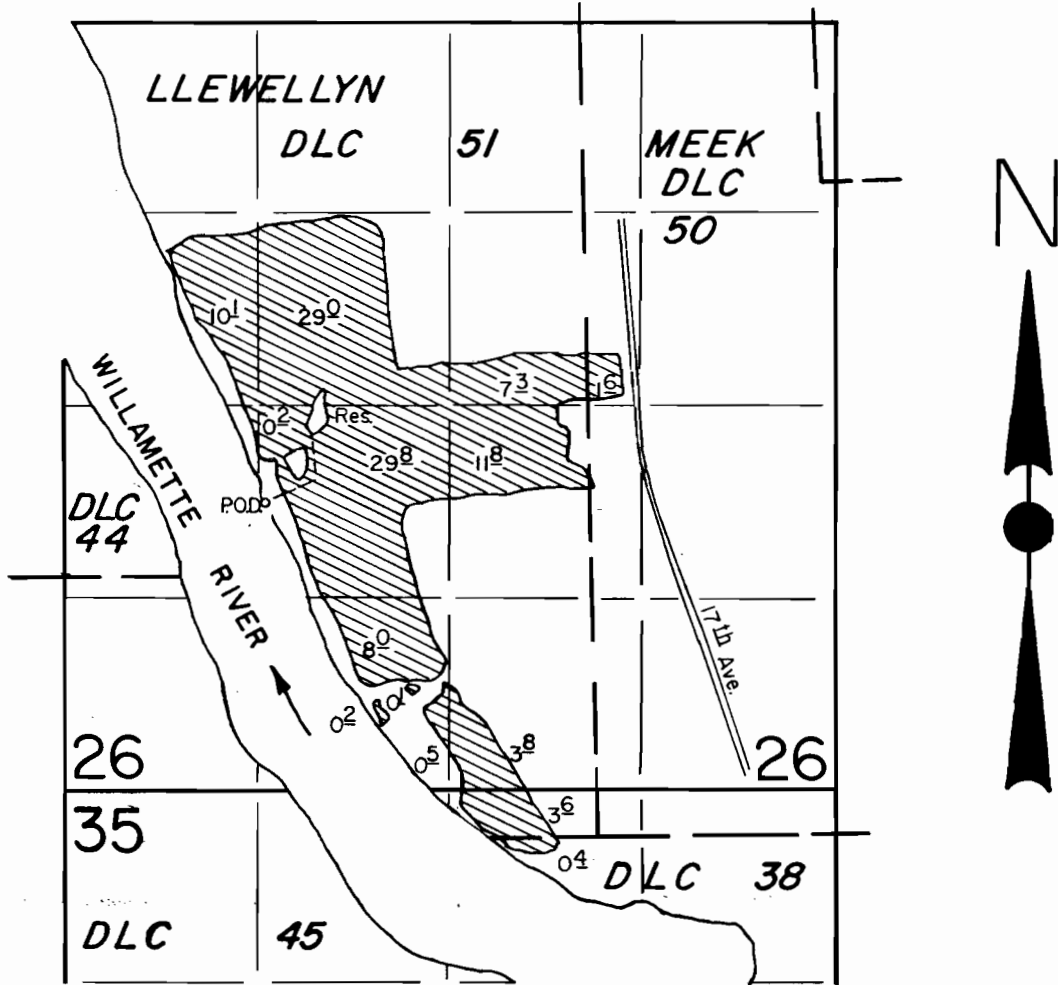

P.O.D. Loc. : 2460' N. & 2240' W. from SE Cor. DLC 51.

Scale : 1" = 1320'

FINAL PROOF SURVEY
UNDER

R-69083 R-10884
Application No. 69084... Permit No. 50092.....

IN NAME OF

WAVERLY COUNTRY CLUB

Surveyed Nov. 9, 1989, by T. Warren