


SEC. 3, T. 34 S., R. 1 W., W.M.

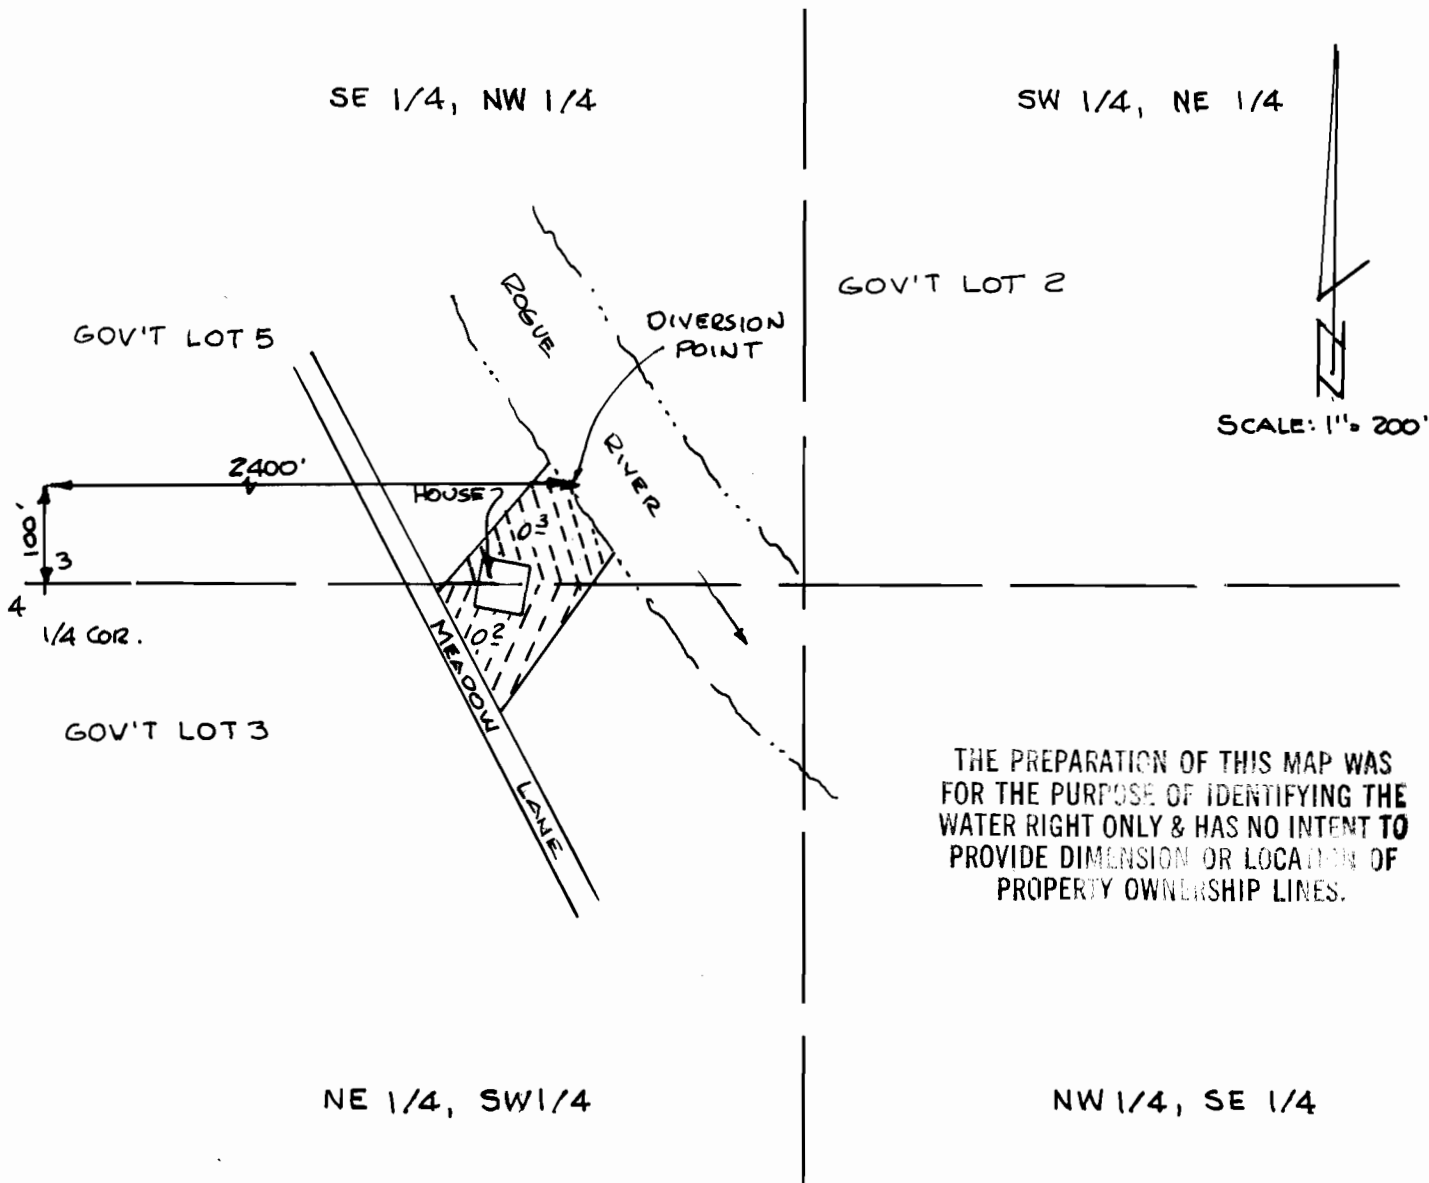

FINAL PROOF MAP

UNDER

APPLICATION NO. 69313 PERMIT NO. 50187

IN NAME OF
EDWARD PRICE

EXAMINED MARCH 14, 1989 BY L.J. FRIAR

