


T28S R14WWM

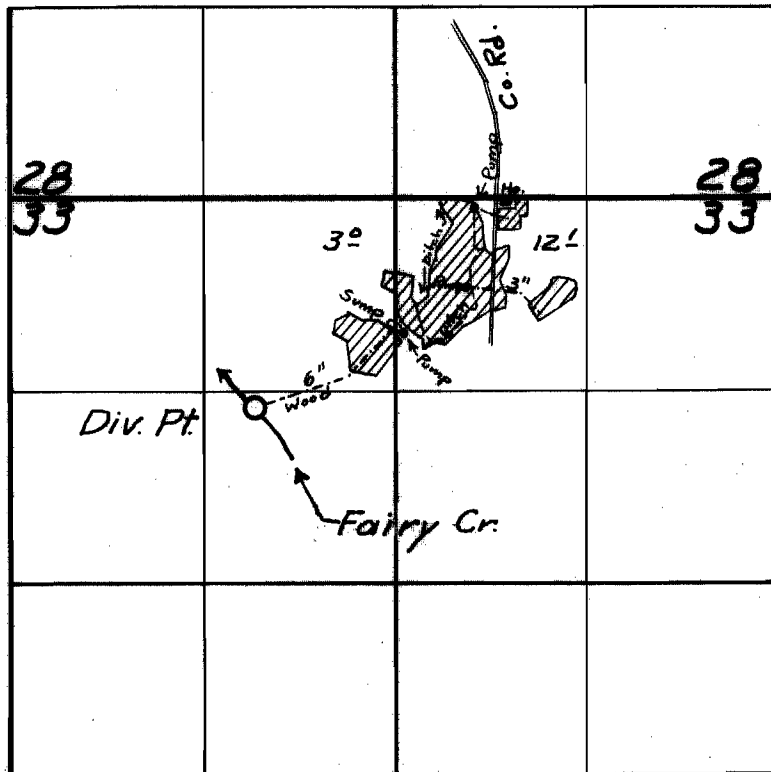

**FINAL PROOF SURVEY**

UNDER

Application No. 20779 Permit No. 16260

IN NAME OF

**E. SUMNER FISH**

Surveyed Aug 18 1955, by M. B. Bial