

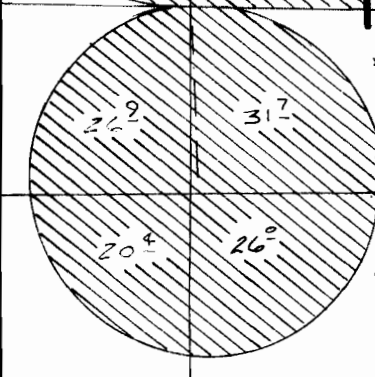
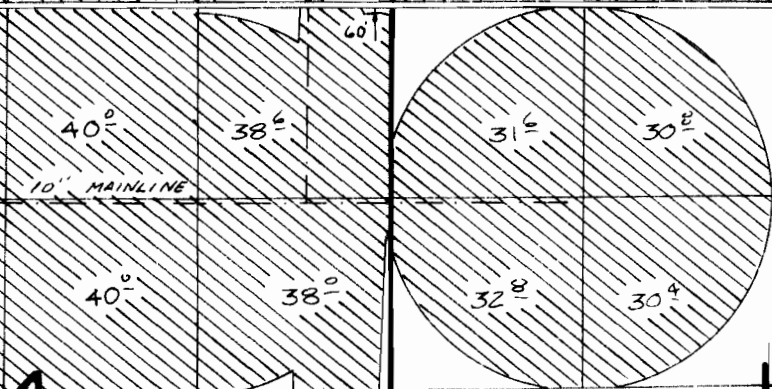
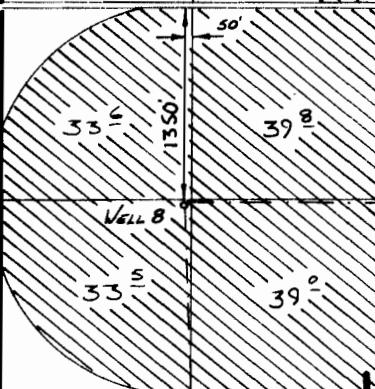
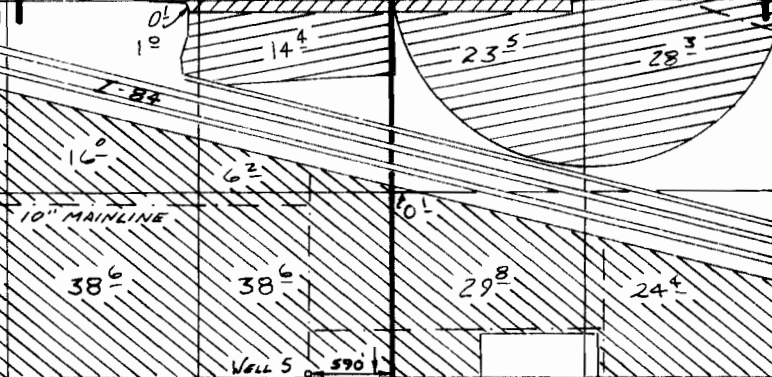
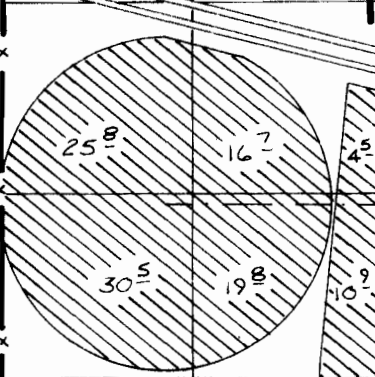
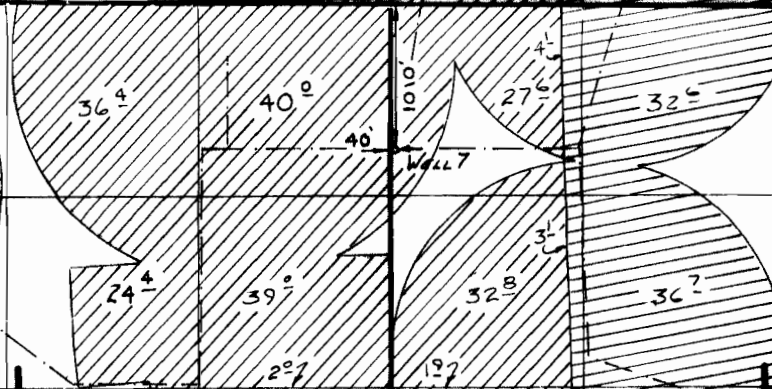


T.3N.,

R. 29E.,

W. M. 2

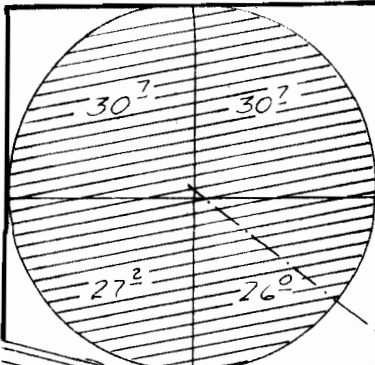

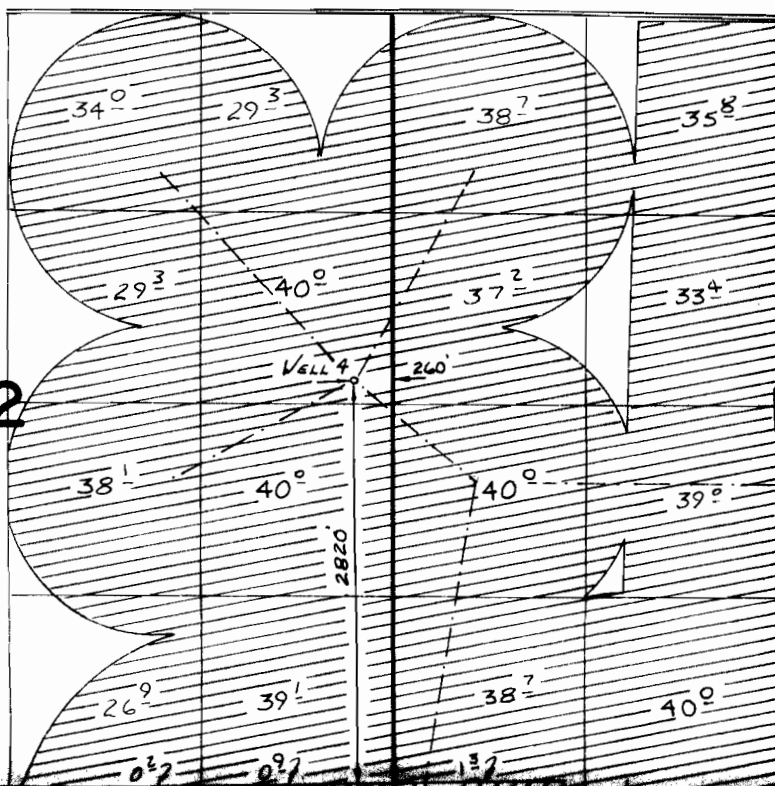


FINAL PROOF SURVEY UNDER

APPL. G-5998 PER. G-5215
IN NAME OF

PRUDENTIAL LIFE INS. OF AMERICA

Surveyed April 20 1983, by V.L. Church

-  - PRIM NORTH OF I-84
-  - SUPPL NORTH OF I-84
-  - PRIM SOUTH OF I-84