


T.7S.,R.2W.,W.M.

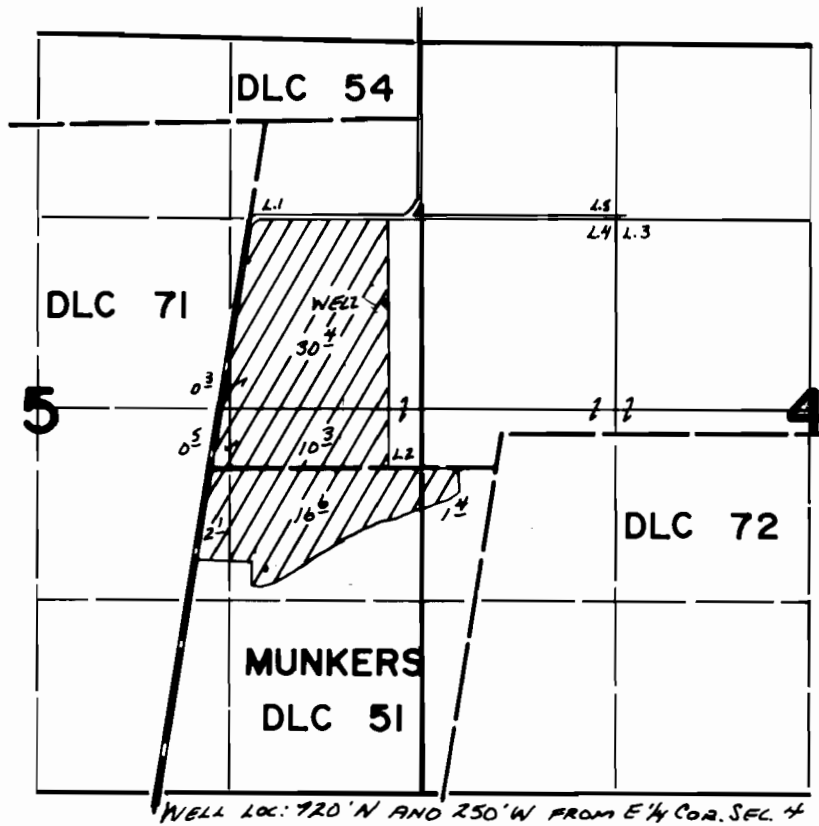

FINAL PROOF SURVEY
UNDER

Application No. G-6155 Permit No. G-5841
IN NAME OF

NORMAN L. & KAY L. McDONALD

Surveyed May 19 1976, by L. TOLL