


T. 40 S., R. 14 W., W.M.

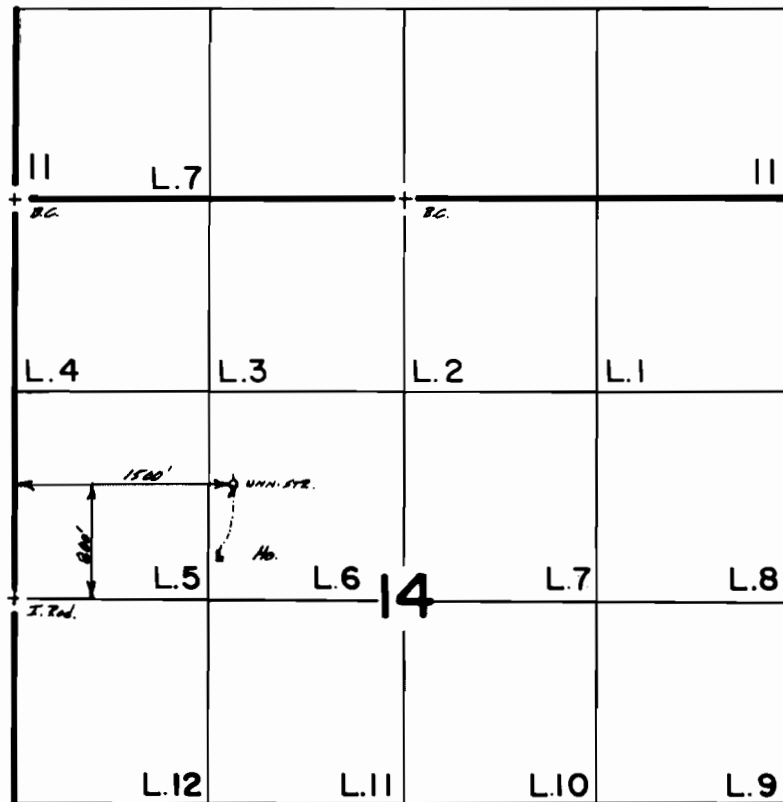

Scale 1" = 1320'

FINAL PROOF SURVEY

UNDER

Application No. 60478. Permit No. 45749....
IN NAME OF

RICK F. & DIANNA K. ROGDIGER

Surveyed Sept. 30 1987, by B.S. JAMES....