


T. 28 S., R. 14 W., W.M.

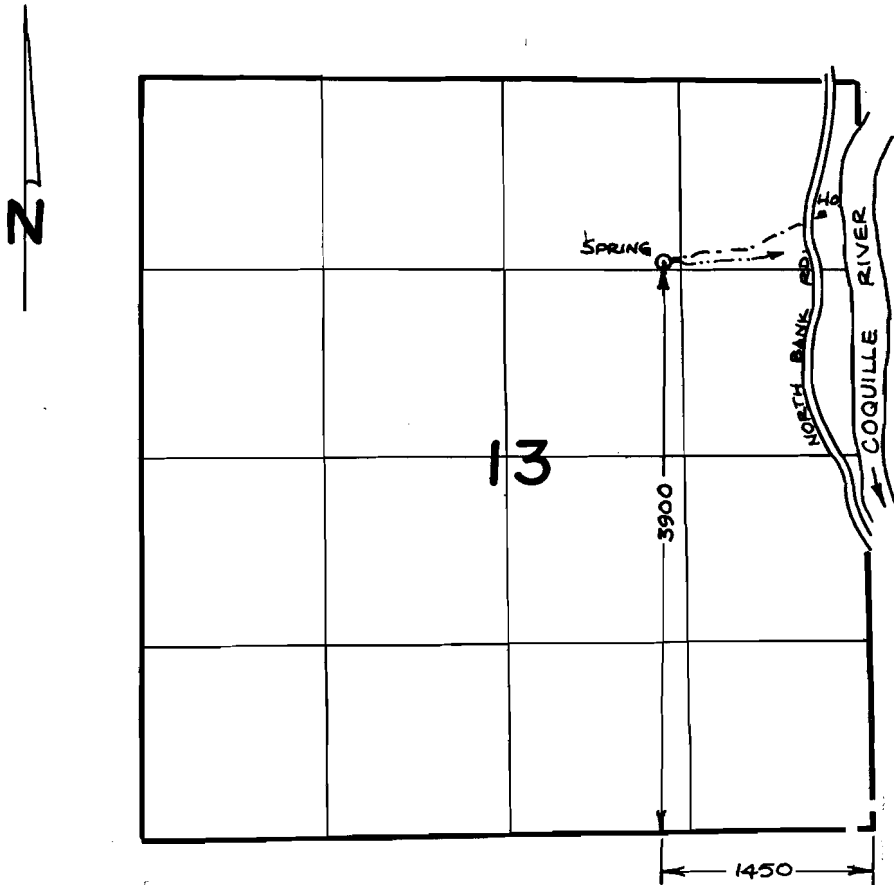

SCALE: 4" = 1 MILE

FINAL PROOF SURVEY
UNDER

Application No. ..61625.. Permit No.45824....
IN NAME OF

BERNARD M. & INGEBORG T. AMDAHL

Surveyed ...6.7.11..... 19.86, by ...M. SCHMORDE..