


T. 2S., R. 5E., W. M.

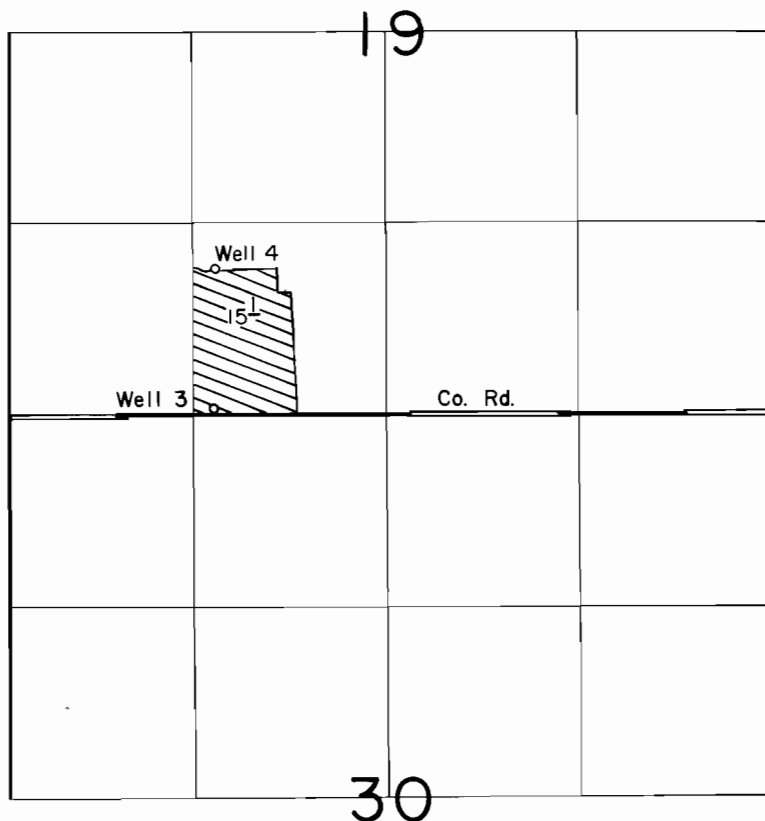

Well 3 Loc.: 40' N. & 1180' W.

Well 4 Loc.: 1000' N. & 1160' W., both from S. 1/4 Cor. Sec. 19

Scale : 1" = 1320'

FINAL PROOF SURVEY

UNDER

Application No. G-11610.. Permit No. G-10684...
IN NAME OF

FRED E. WICKERSHAM

Surveyed AUG. 11. 1989., by R. KLASSEN.....