


T. 4 S., R. 1 E., W. M.

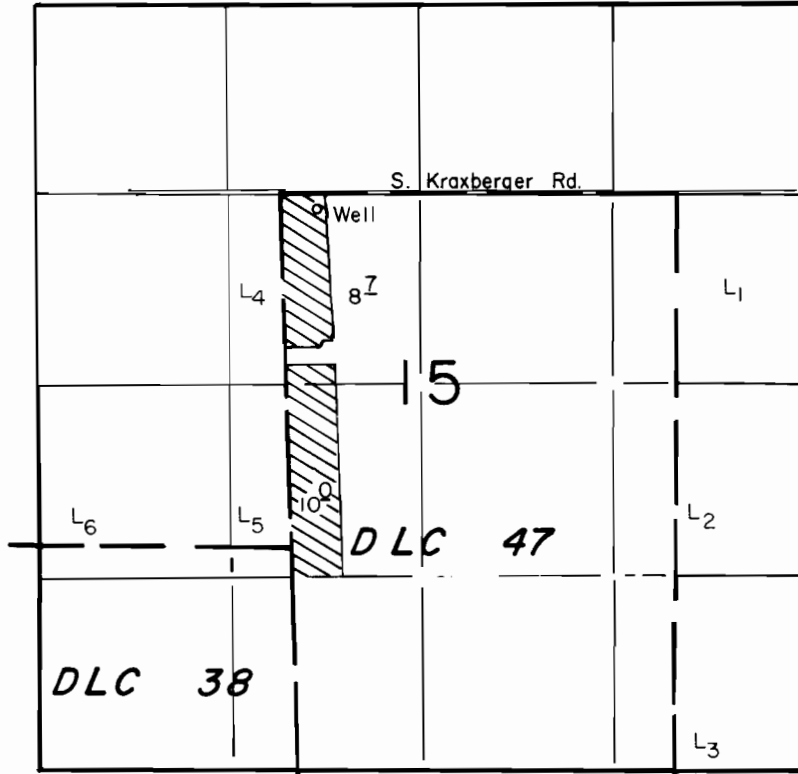

Well Loc.: 110' S. & 250' E. from NW Cor. DLC 47

Scale : 1" = 1320'

FINAL PROOF SURVEY UNDER

Application No. G-11646 Permit No. G-10793

IN NAME OF

LEWIS JOHN SIRI

Surveyed JULY 25, 1989, by R. KLASSEN