


T. 28 S., R. 4 W., W. M.

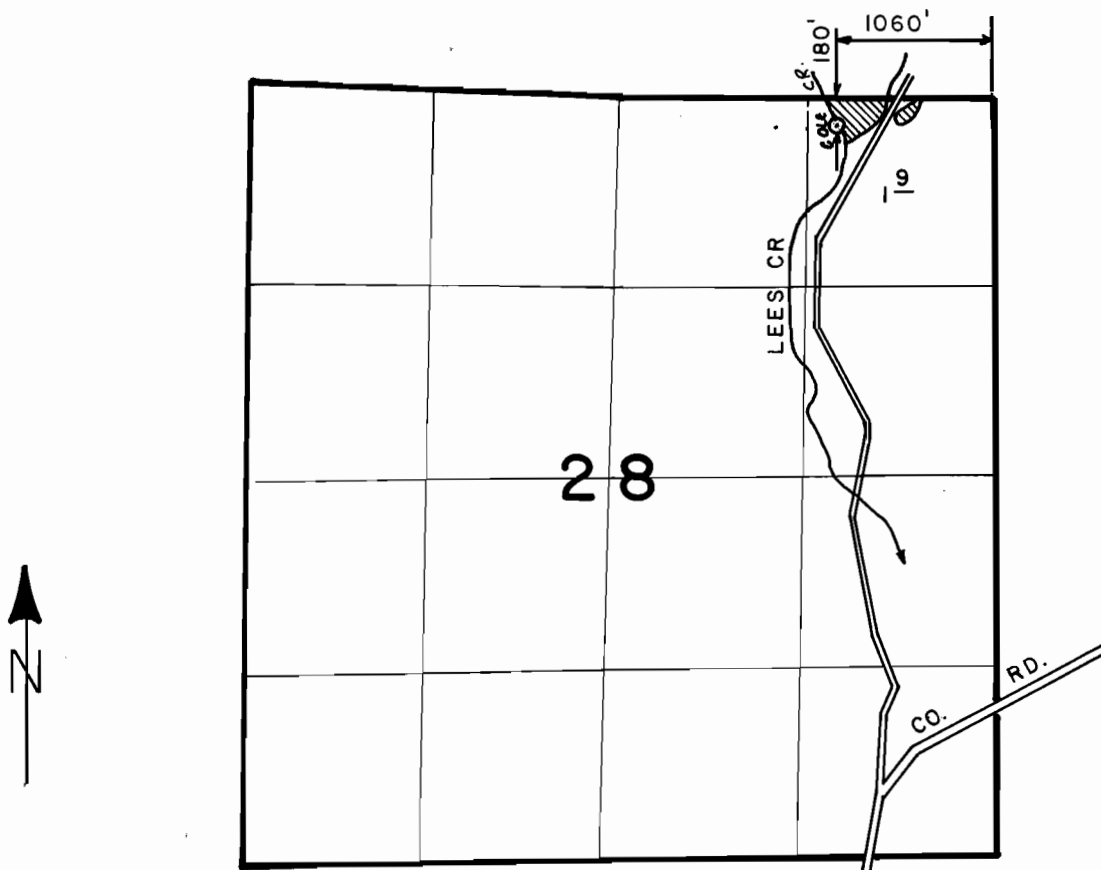

SCALE: 4" = 1 MILE

FINAL PROOF SURVEY
UNDER

Application No. 58957 Permit No. 44488
IN NAME OF

GEORGE D. TATUM

Surveyed AUG. 3 1988, by J. M. SCHMORDE