



# T. 35 S., R. 14 W., W. M.

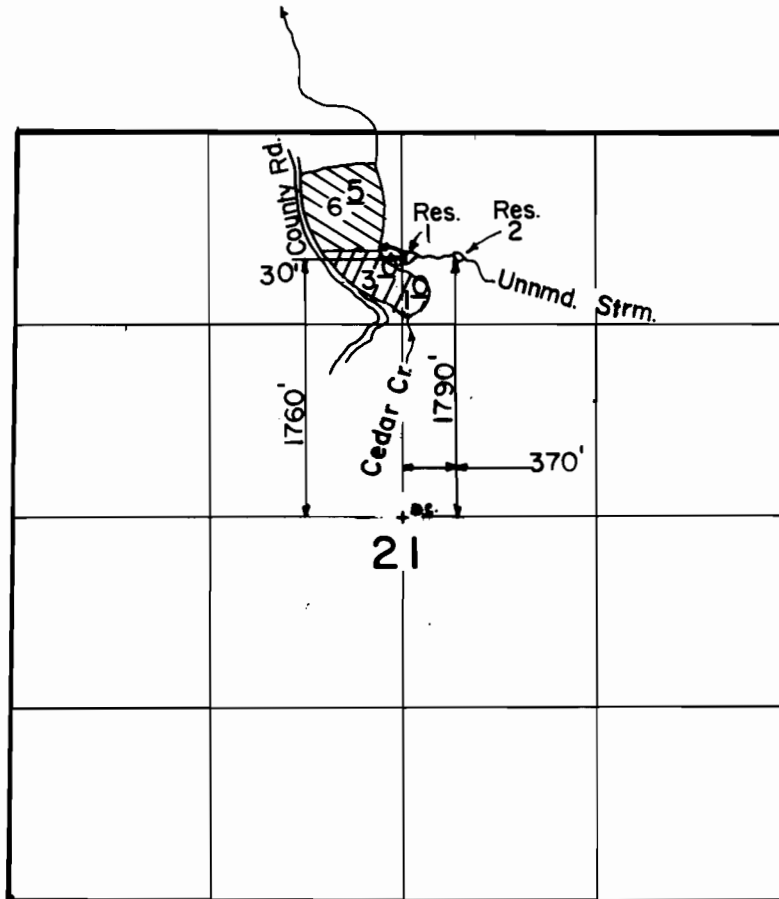

Scale: 1" = 1320'

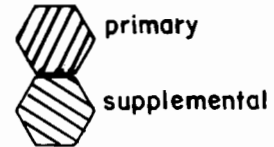

## FINAL PROOF SURVEY UNDER

R-59667      R-8223  
 Application No. 59184      Permit No. 45445  
 IN NAME OF

JOHN F. WILSON

Surveyed JUL. 22. 1988, by B. S. JAMES