


T. 28 S., R. 13 W., W.M.

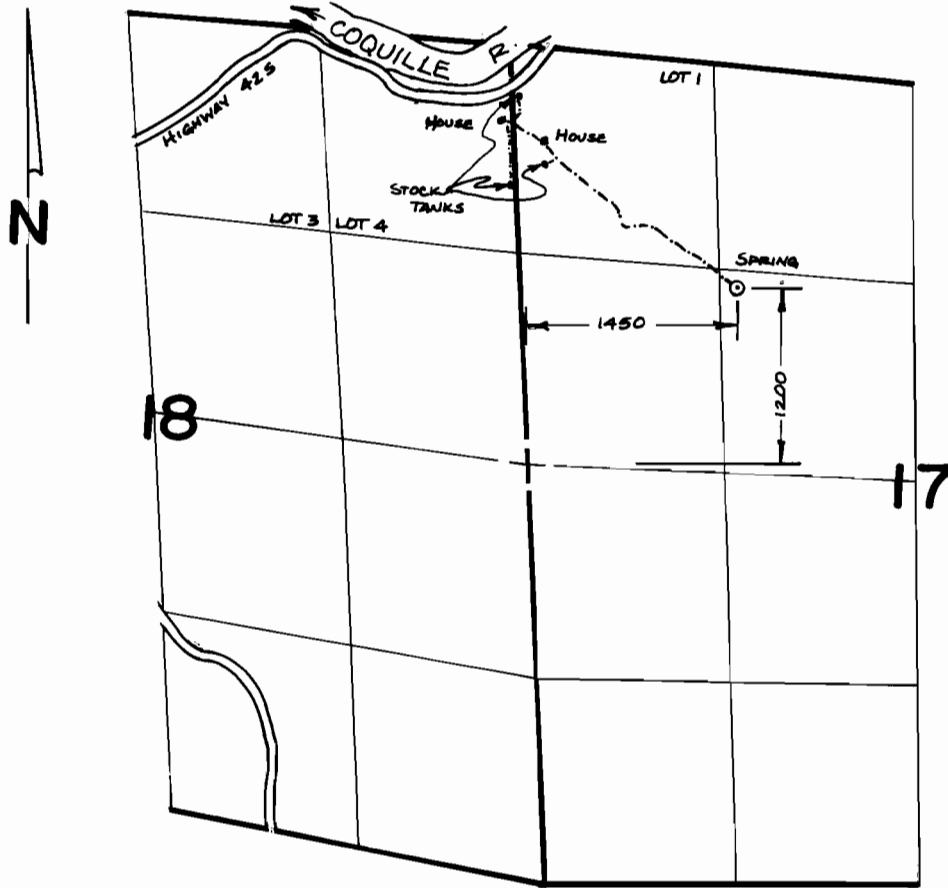

SCALE : 4" = 1 MILE


FINAL PROOF SURVEY UNDER

Application No. .596.69. Permit No.44851....
IN NAME OF

.....TOM THURMAN.....

Surveyed3/18.... 19.88, by ...M.SCHMORDE....

T. 35 S., R. 14 W., W. M.

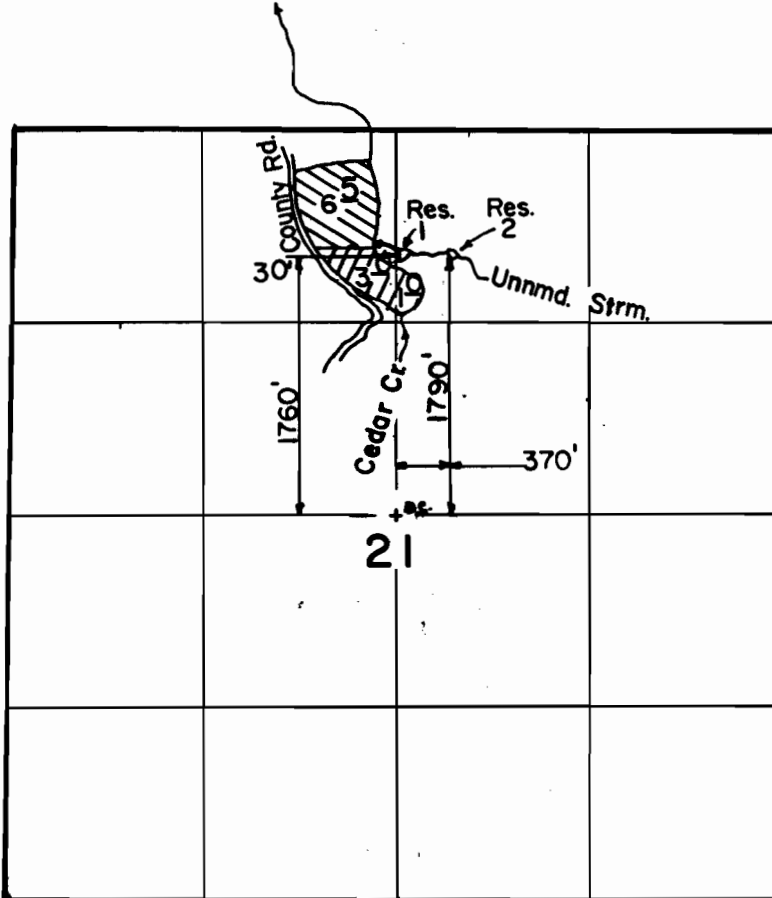

Scale: 1" = 1320'



primary

supplemental

SUP

FINAL PROOF SURVEY
UNDER

Application No. **R-59667** Permit No. **R-8223**
59184 **45445**
IN NAME OF

JOHN F. WILSON

Surveyed **JUL. 22. 1988.** by **B. S. JAMES**