


# T. 27 S., R. 7 W., W. M. SECTION 10

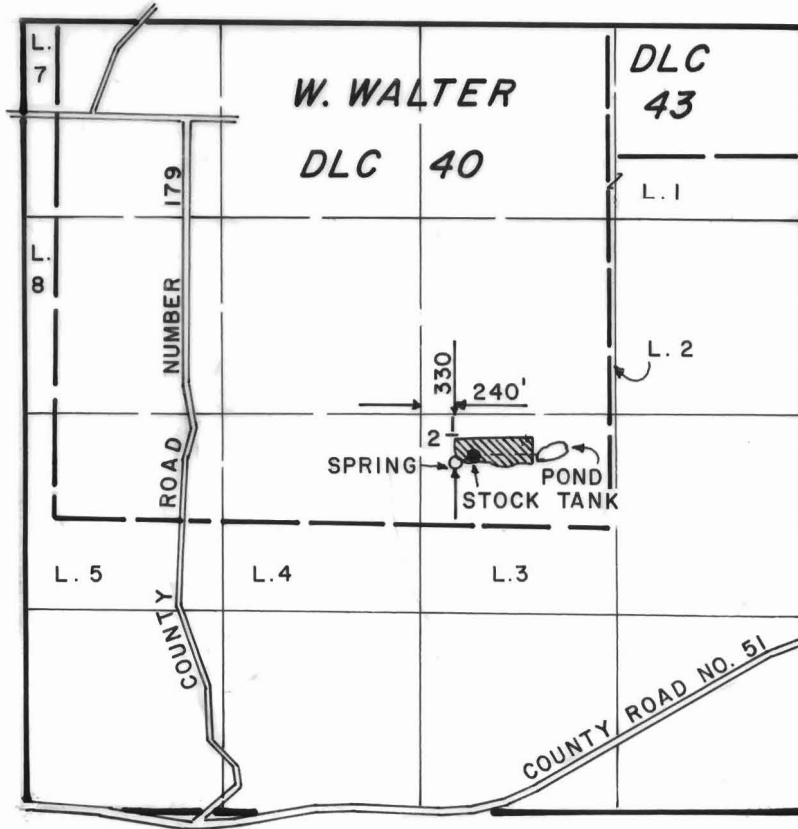

SCALE: 4" = 1 MILE

## FINAL PROOF SURVEY UNDER

Application No. 59529.. Permit No. 44767.....  
IN NAME OF

**FREEMAN & CHRISTINE MARTIN**

Surveyed JUNE 27, 1988, by J. M. SCHMORDE