


T. 28 S., R. 13 W., W.M.

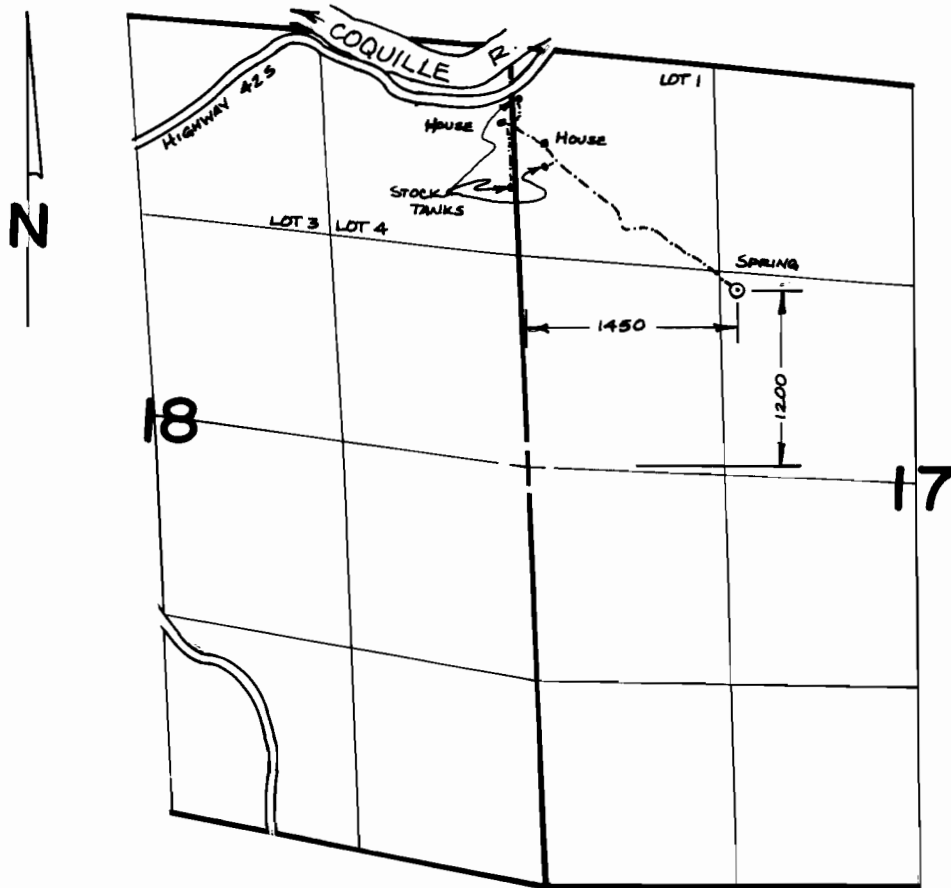

SCALE : 4" = 1 MILE

FINAL PROOF SURVEY UNDER

Application No. .59669. Permit No.44851....
IN NAME OF

.....TOM THURMAN.....

Surveyed3/18.... 19.88, by ...M. SCHMORDE....