


T. 40 S., R. 14 W., W.M.

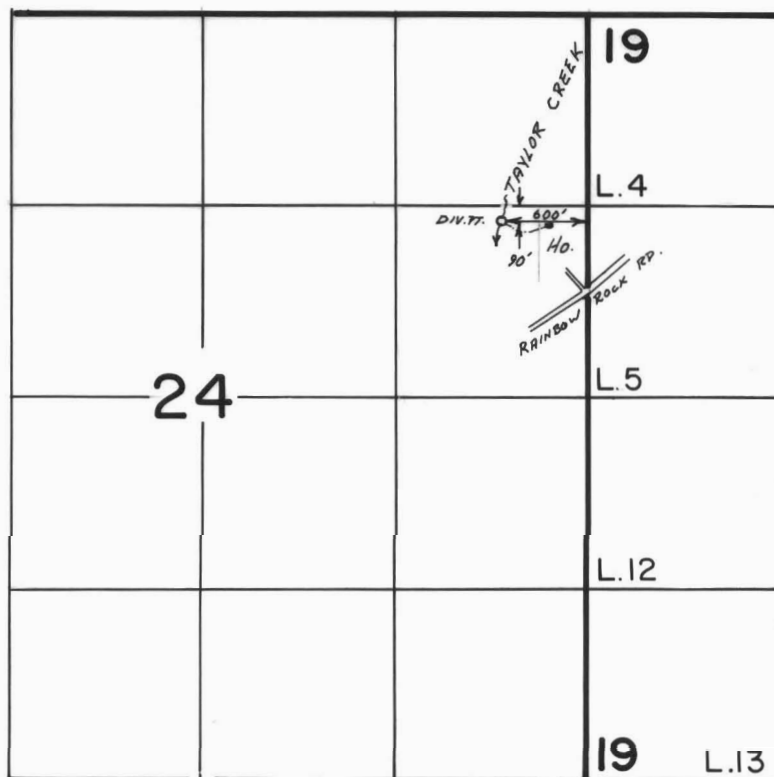

Scale 1" = 1320'

FINAL PROOF SURVEY
UNDER

Application No. 59540 Permit No. 44693...
IN NAME OF

WENDELL DEAN VAUGHN...

Surveyed Oct. 12, 1988, by B.S. JAMES.....