


T. 9 S., R. 15 E., W.M.

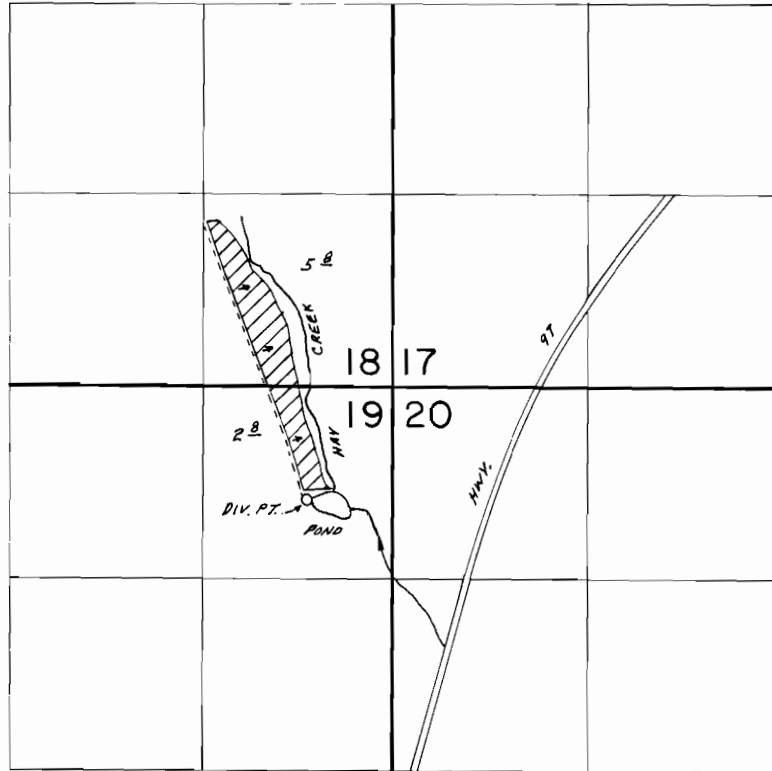

DIV. LOC.: 770' S. & 580' W. FROM NE COR. SEC. 19

SCALE: 1"=1320'

FINAL PROOF SURVEY UNDER

Application No. 59704.. Permit No. 4550!.....
IN NAME OF

..... FLOYD BAUER

Surveyed AUG. 22 19.88, by B. BISHOP.....