


P-45044
65504

T.13&14S., R.30E., W.M.

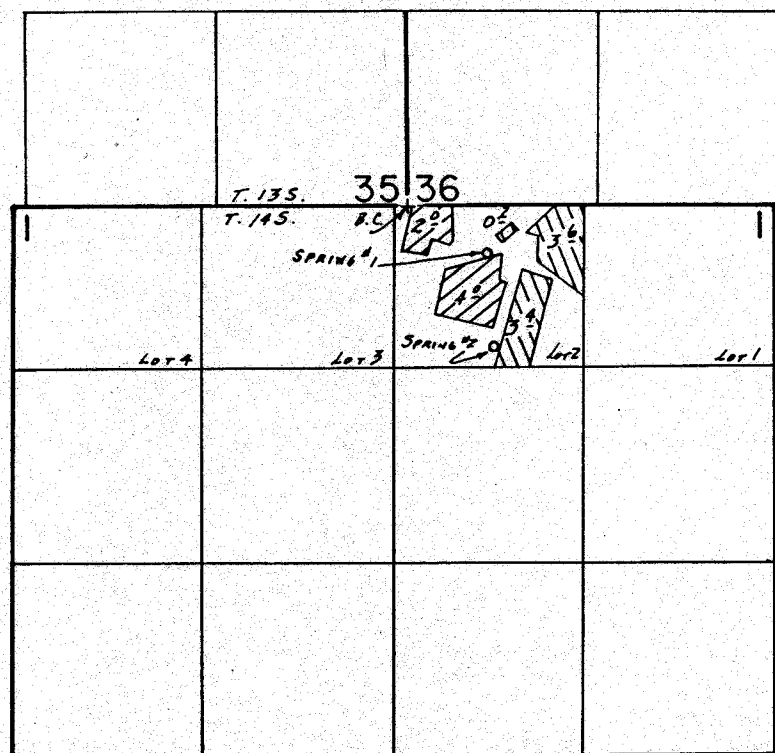

SPRINGS LOC.: 1-330'S. & 550'E.; 2-970'S. & 600'E., BOTH
FROM SW COR. SEC. 36.

SCALE: 1" = 1320'

 SPRING 1
 SPRING 2

FINAL PROOF SURVEY UNDER

Application No. 60099.. Permit No. 45044.....
IN NAME OF

.....DARRELL & LINDA COOK.....

Surveyed June 18... 1988, by Z.F. SALEH.....