


T. 35 S., R. 14 W., W. M.

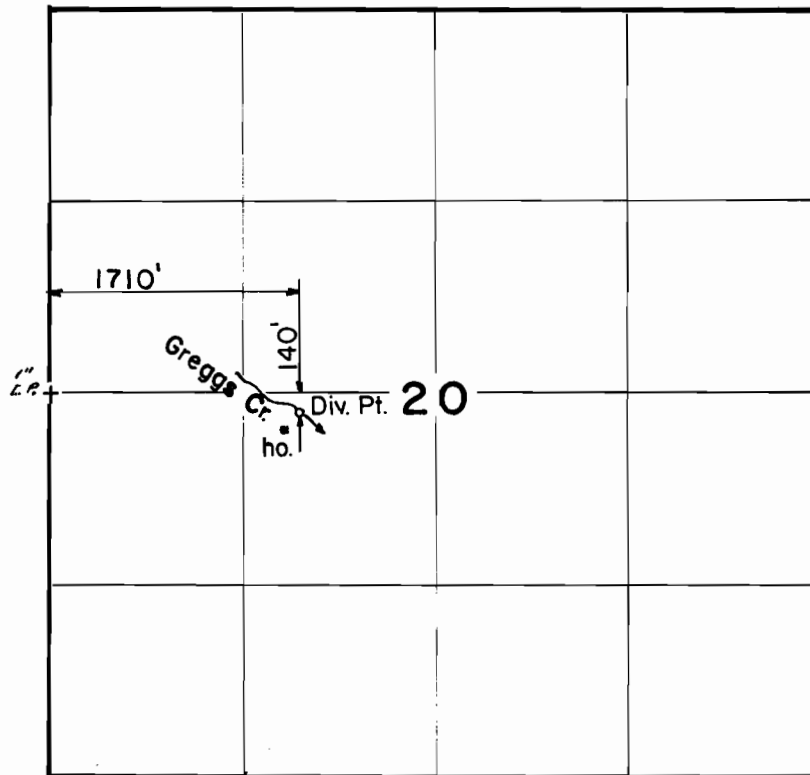

Scale: 1" = 1320'

FINAL PROOF SURVEY

UNDER

Application No. 60313 Permit No. 45170.....
IN NAME OF

.....DAN O. WILSON.....

Surveyed JUL. 25. 1988, by B. S. JAMES....