


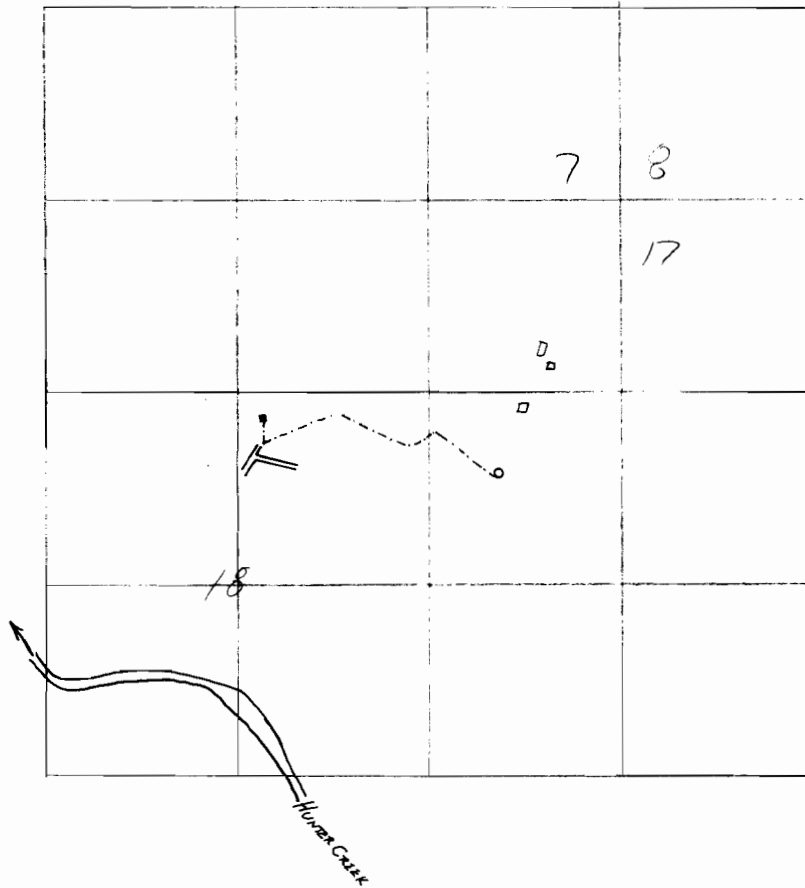

FINAL PROOF SURVEY **UNDER**

60329

72741

Application No. Permit No.
 IN NAME OF

NYDER

Surveyed 19....., by

4015-181-512

41015-180-304