




T. 37 S., R. 14 W., W.M.

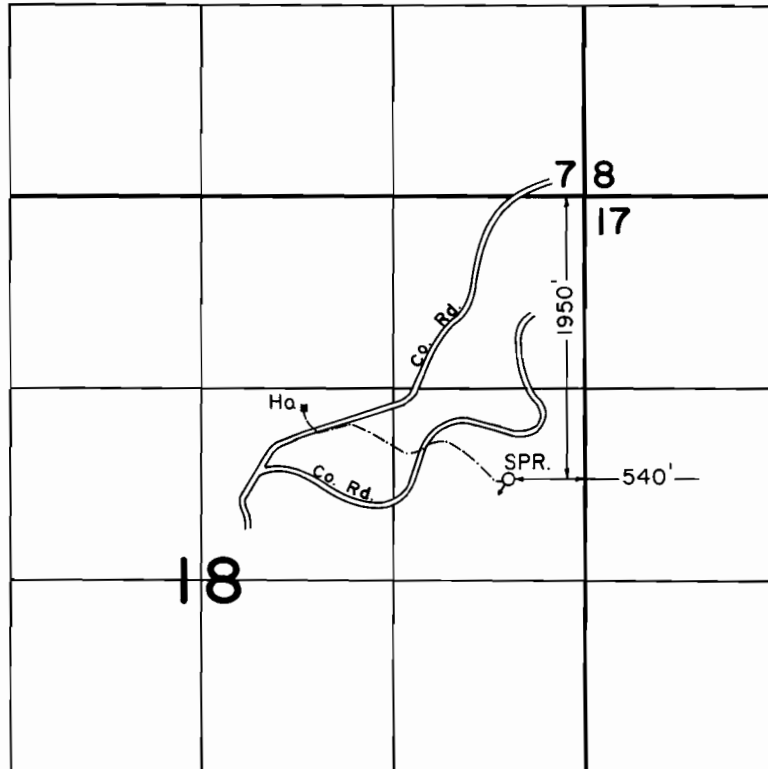

SCALE: 1" = 1320'

FINAL PROOF SURVEY
UNDER

Application No. 60330, Permit No. 44942.....
IN NAME OF

MICHAEL G. WHITE.....

Surveyed JULY 27, 1988, by B.S. JAMES.....