




T. 36 S., R. 7 W., W.M.

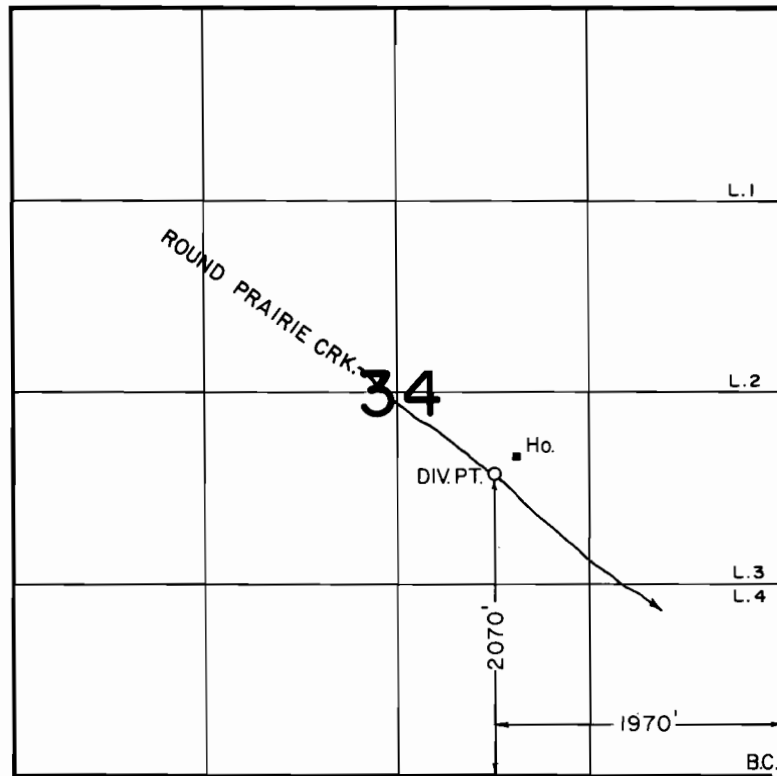

SCALE: 1" = 1320'

FINAL PROOF SURVEY UNDER

Application No. 60343 Permit No. 45134
IN NAME OF

ALEXANDER R. KENDRICK

Surveyed MAY 25, 1989, by B. S. JAMES

12-15-89

41033-179-169 R

JS