



T.3S., R.45E., W.M.

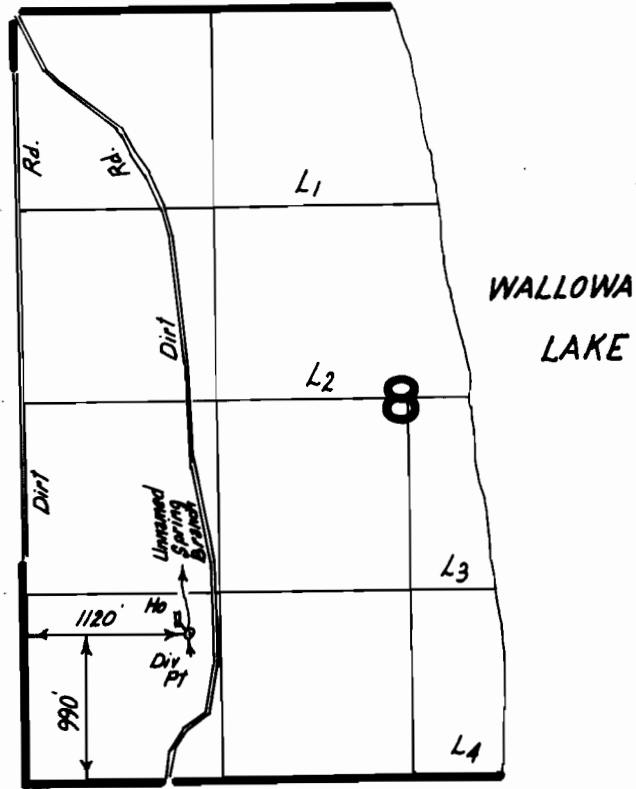

FINAL PROOF SURVEY UNDER

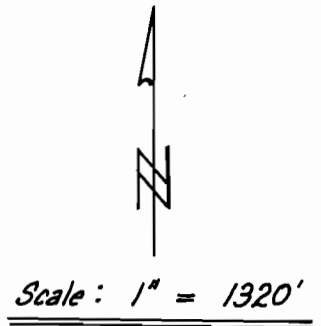

Application No. **60426** Permit No. **45112**.....
IN NAME OF

.....**ARNOLD E. SMITH**.....

Surveyed **8-15** 1988., by **Vern Church**.....