


T.11S., R.40E., W.M.

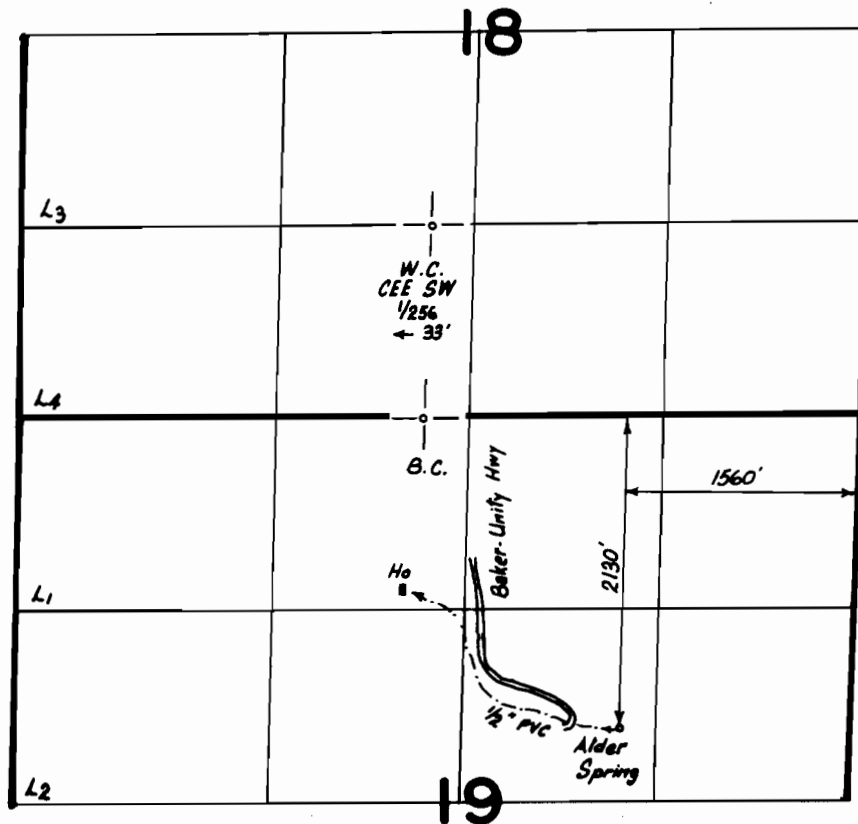

FINAL PROOF SURVEY UNDER

Scale: 1" = 1320'

Application No. 60487 Permit No. 46642
IN NAME OF

DONALD D. & GLORIA J. ROHWER

Surveyed 8-3 1988, by Vern Church