


# T. 27S., R. 7 W., W. M.

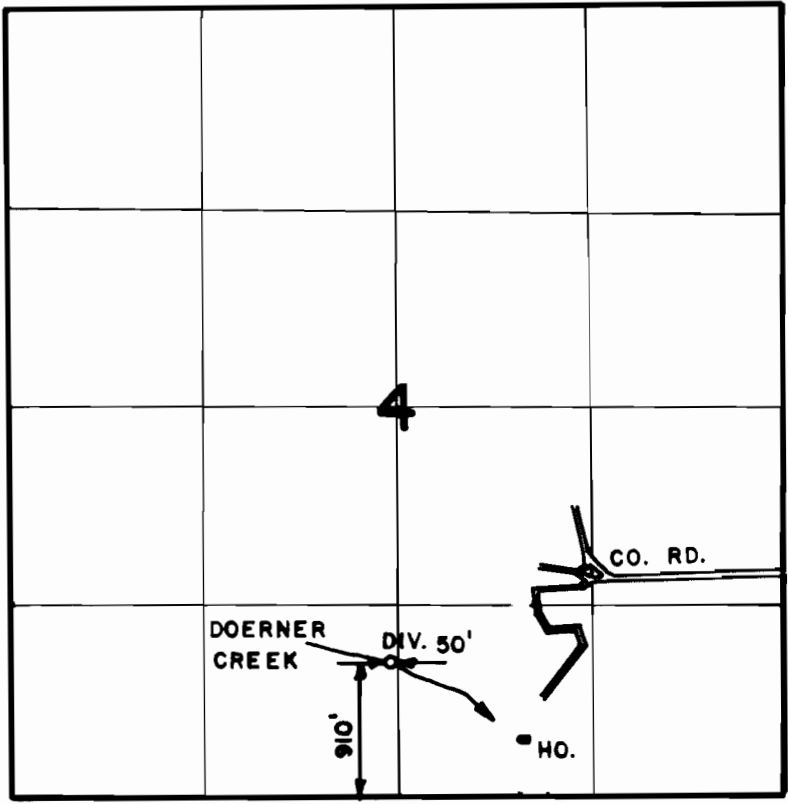

SCALE: 4" = 1 MILE

## FINAL PROOF SURVEY UNDER

Application No. 60531... Permit No. 46230.....  
IN NAME OF

**THOMAS E. AND DORIS C. COULTAS**

Surveyed JUNE 27, 1988, by J.M. SCHMORDE