


T. 40S., R. 14 W., W.M.

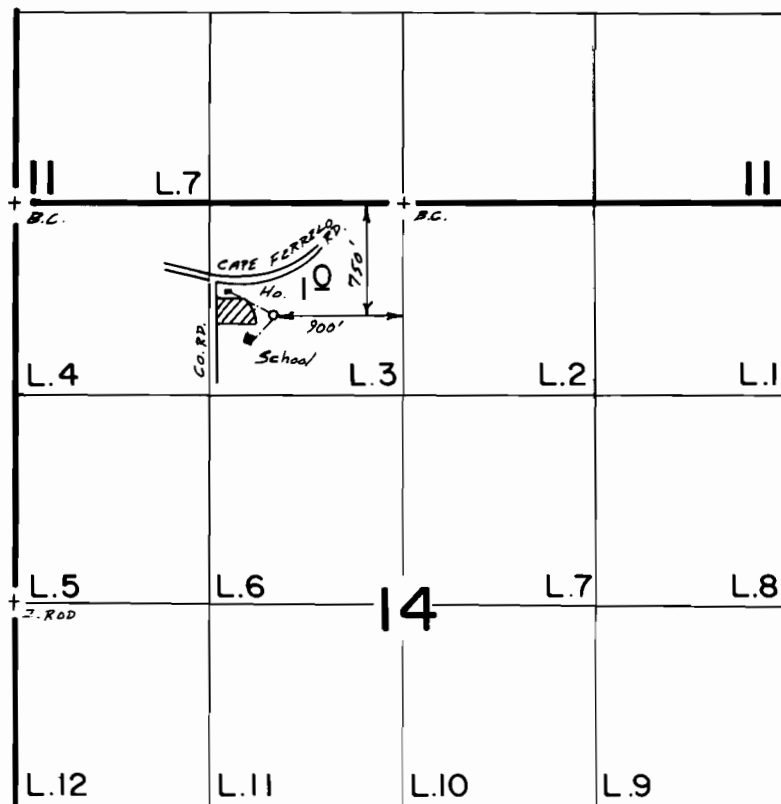

Scale 1"=1320'

FINAL PROOF SURVEY

UNDER

Application No. 60887... Permit No. 46196.....
IN NAME OF

CAPE FERRELO ADVENTIST SCHOOL

Surveyed Oct. 12, 1988, by B.S. JAMES.....