


T. 5 & 6N., R. 43E., W.M.

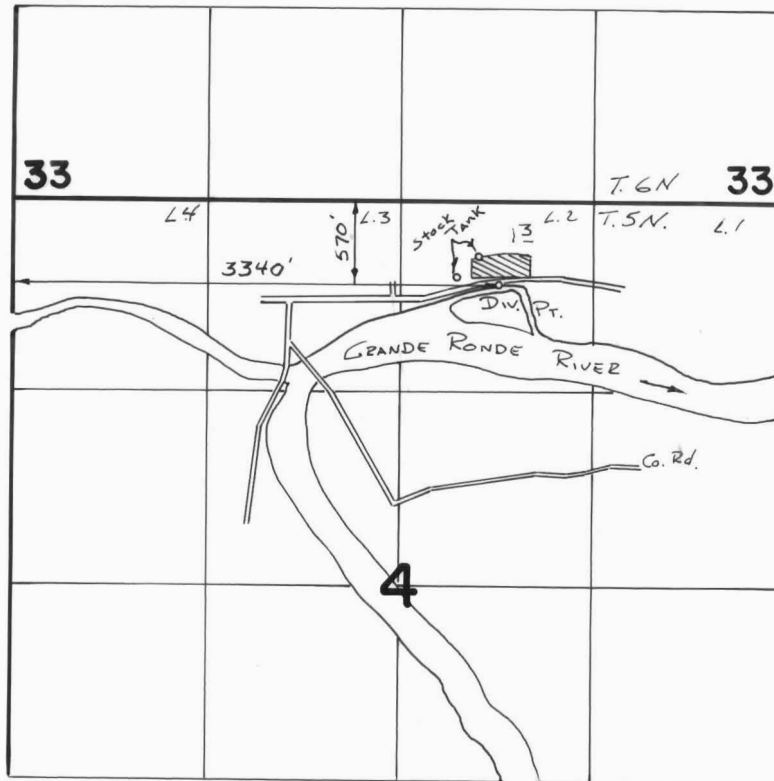

SCALE 1" = 1320'

FINAL PROOF SURVEY UNDER

Application No. **61063** Permit No. **45472**..
IN NAME OF

ROLLAND SLATTER.....

Surveyed **8-16**..... **1988**, by **V.L. Church**.....