




T. 37 S., R. 14 W., W.M.

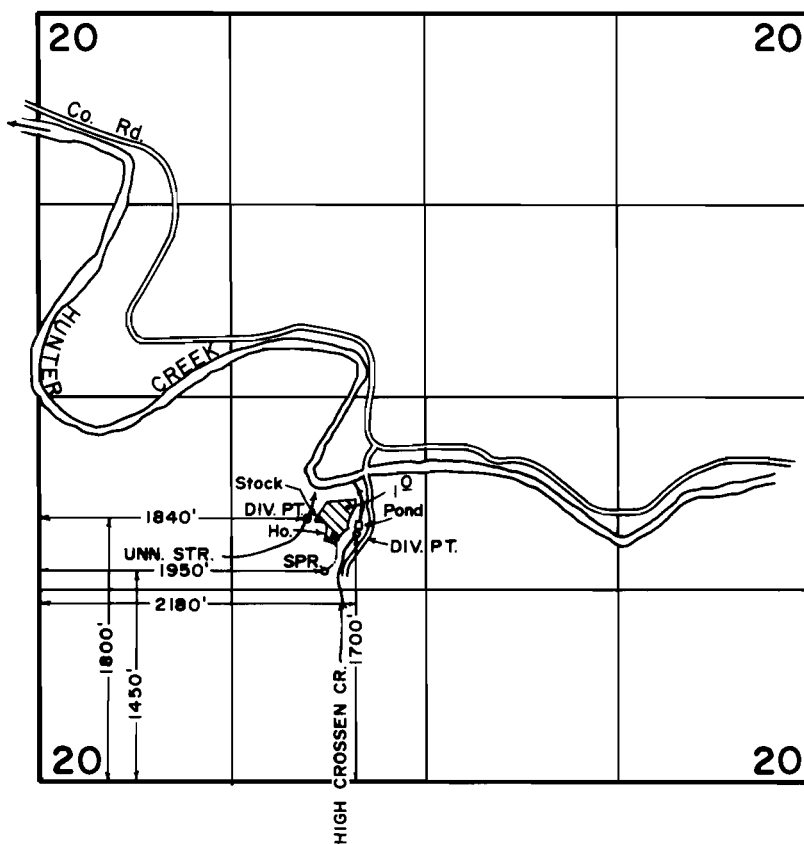

SCALE: 1" = 1320'

FINAL PROOF SURVEY UNDER

Application No. 60585... Permit No. 45313.....
IN NAME OF

MARJORIE M. CROSSEN

Surveyed JULY 28 1989, by B. S. JAMES.....