




# T. 37 S., R. 14 & 15 W., W.M.

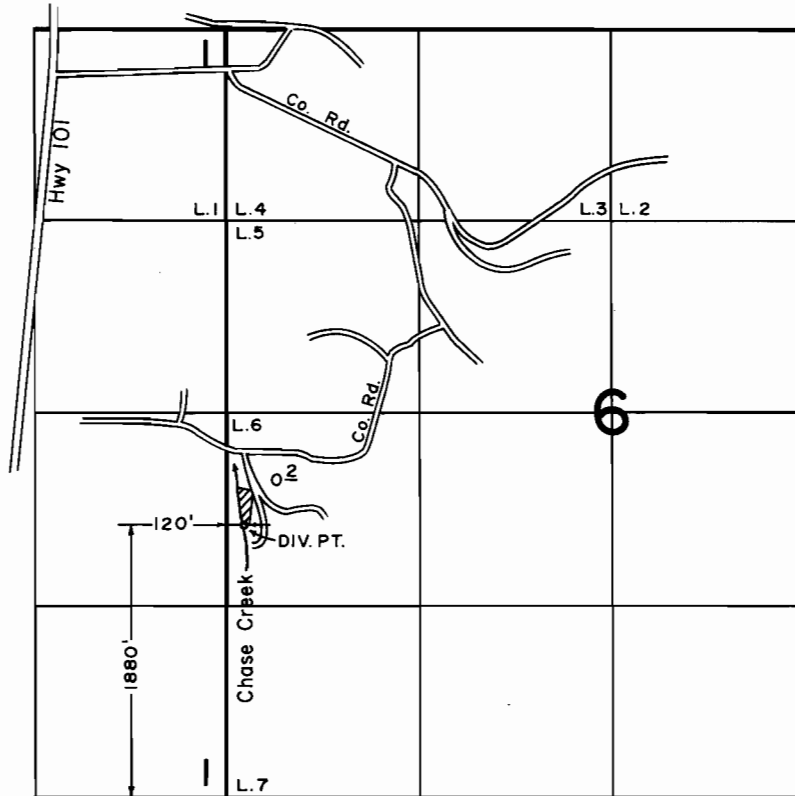

SCALE: 1" = 1320'

## FINAL PROOF SURVEY UNDER

Application No. 61148... Permit No. 45538...  
IN NAME OF

MARJORIE M. CROSSEN

Surveyed JULY 28 1989, by B.S. JAMES