


T.27S., R.13W., W.M.

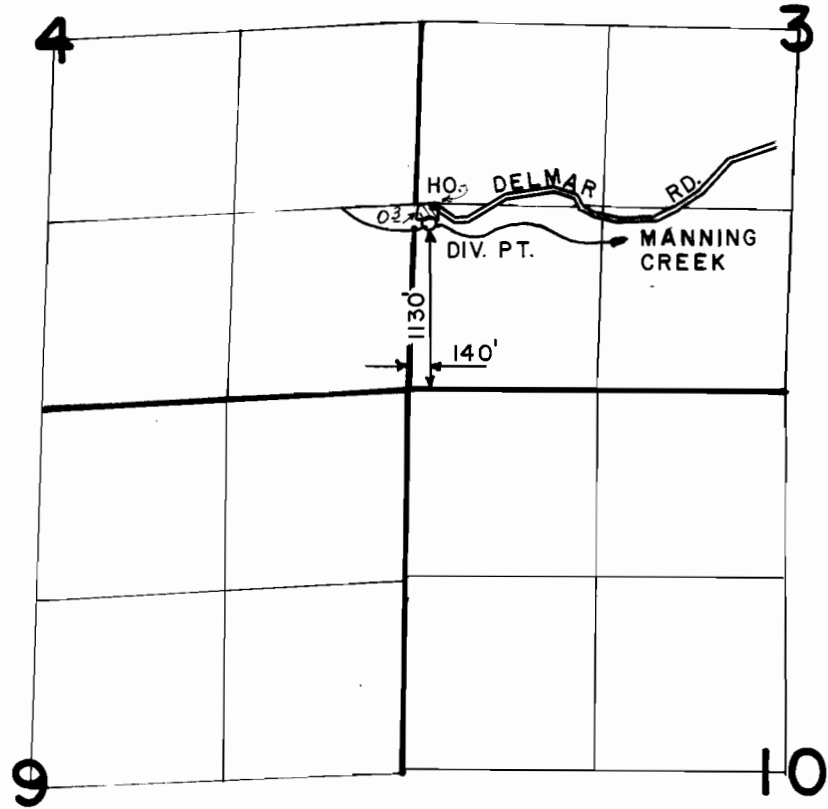

SCALE: 4" = 1 MILE

FINAL PROOF SURVEY
UNDER

Application No. 61552..... Permit No. 45848.....
IN NAME OF

BILL L. JOHNSON

Surveyed MAR. 20, 1988, by J.M. SCHMORDE