


T. 35 S., R. 14 W., W. M.

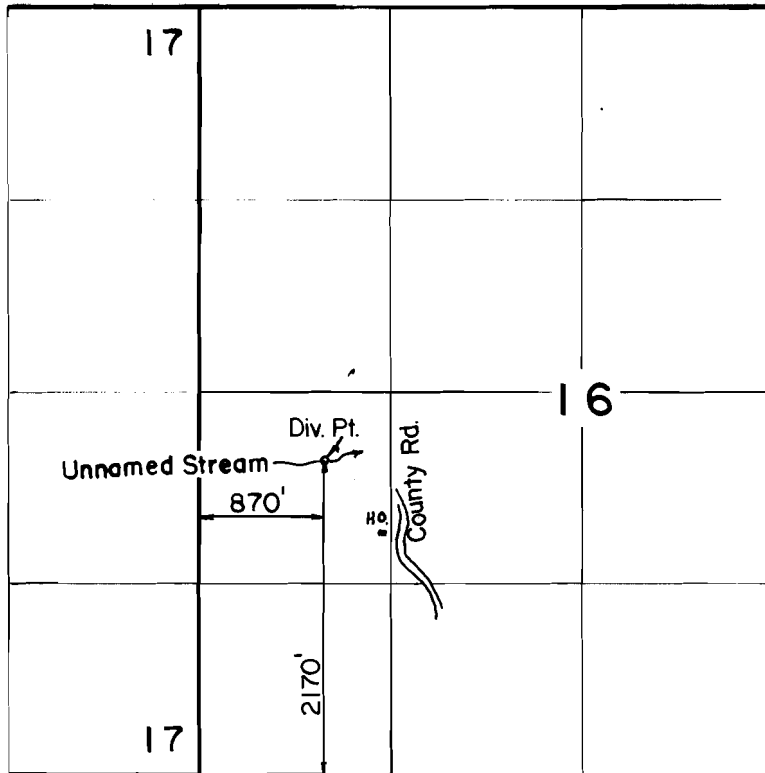

Scale: 1" = 1320'

FINAL PROOF SURVEY
UNDER

Application No. 63114 Permit No. 46661
IN NAME OF

JOHN TYRHOLM

Surveyed JUN. 29. 1988, by B. S. JAMES...