


T. 37 S., R. 6 W., W. M.

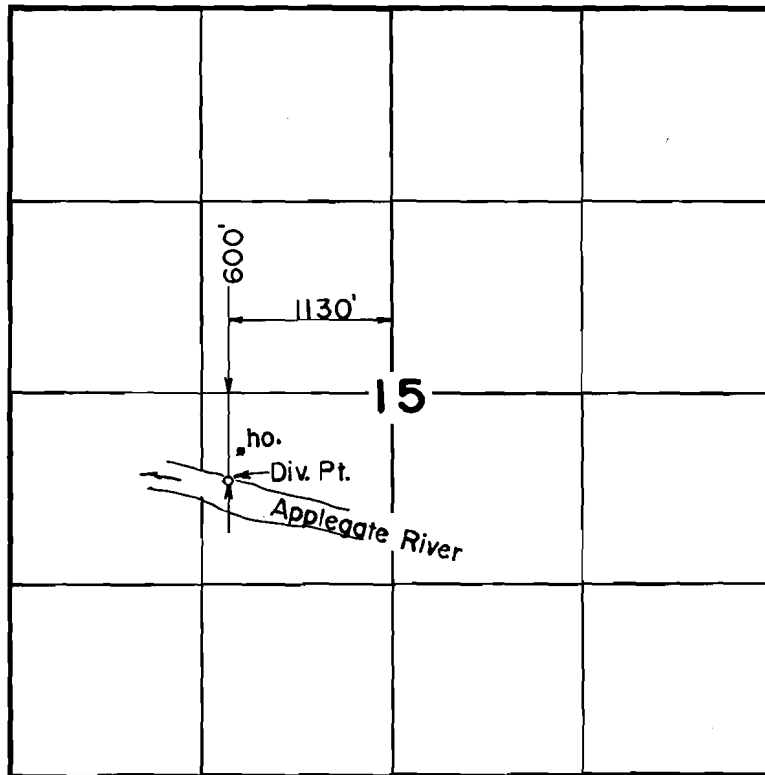

Scale: 1" = 1320'

FINAL PROOF SURVEY
UNDER

Application No. 63842 Permit No. 47088...
IN NAME OF

EDWARD G. & SONDR A. C. ROBINSON

Surveyed MAY 25, 1988, by B. S. JAMES...