


T. 29 S., R. 8 & 9 W., W. M.

W. P. DAY

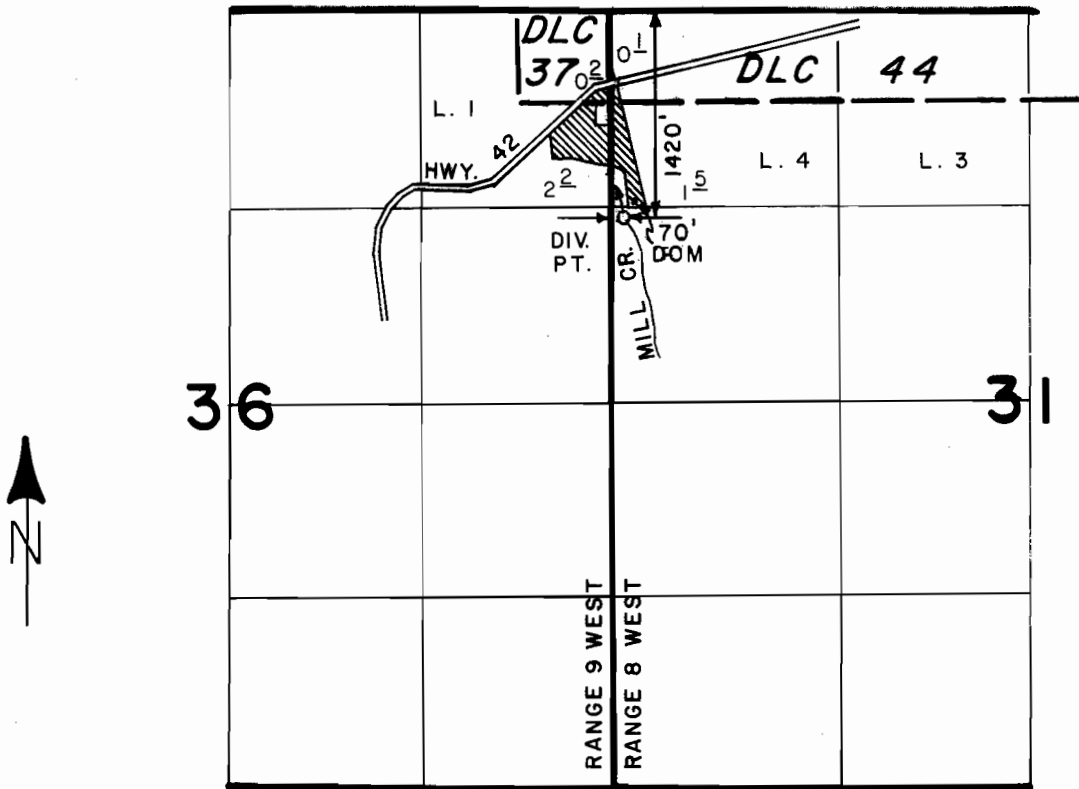

SCALE: 4" = 1 MILE

**FINAL PROOF SURVEY**  
UNDER

Application No. 64802... Permit No. 47366  
IN NAME OF

**BEULAH B. (CARTER) BURTON**

Surveyed JUNE 22, 1988, by J. M. SCHMORDE