
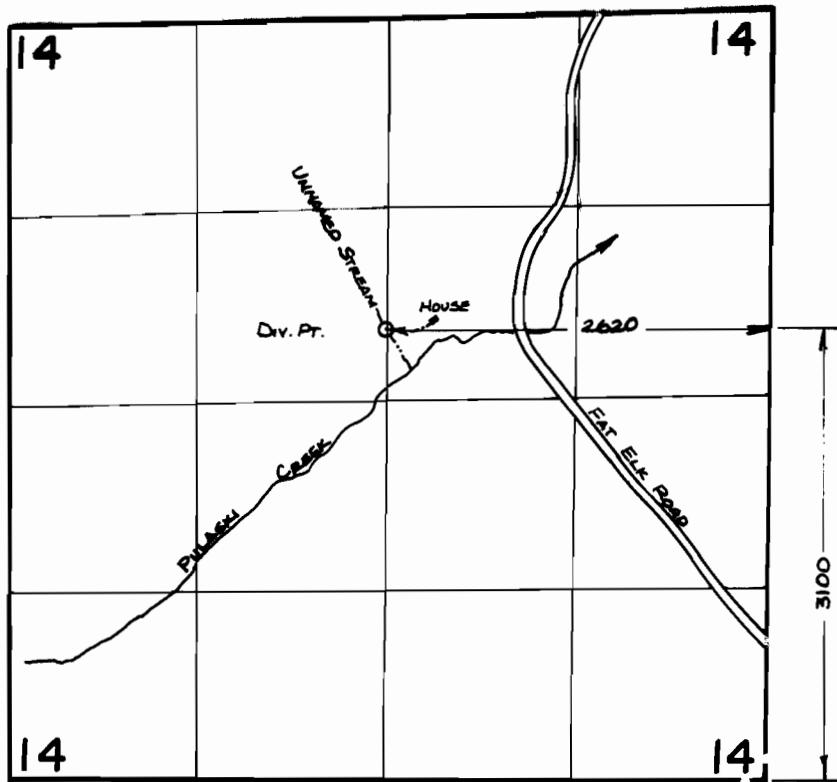


T. 28 S., R. 13 W., W.M.

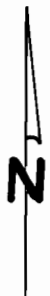

SCALE: 4" = 1 MILE

FINAL PROOF SURVEY UNDER

Application No. ...65088. Permit No. ...47571.....
IN NAME OF

.....TERRY L. ROBINSON.....

Surveyed ...3/17.... 19.88., by ...M. SCHMORDE...