


T.13 S., R. 33 E., W.M.


P-47661  
L-65523

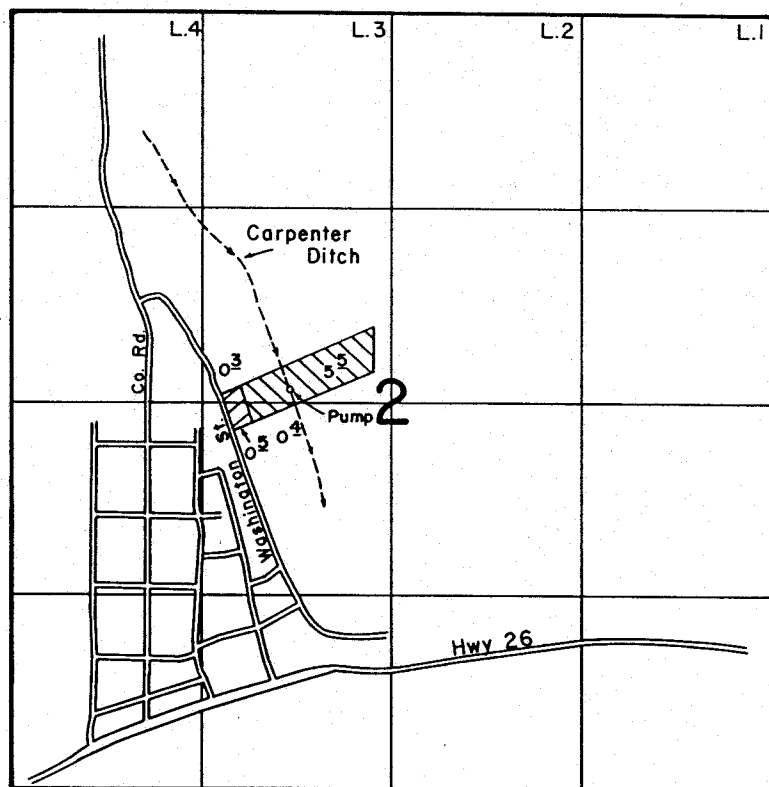

SCALE: 1" = 1320'



T. 12 S., R. 33 E., W.M.

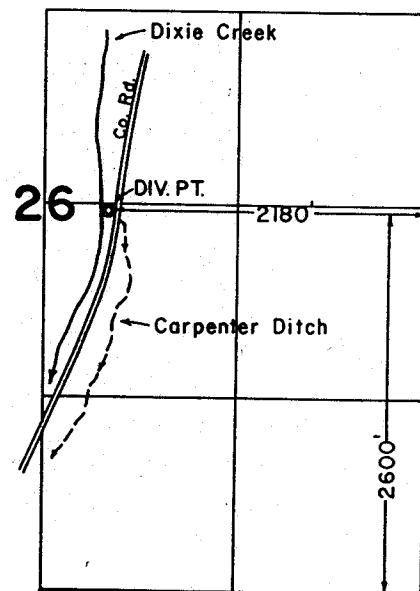

**FINAL PROOF SURVEY**  
UNDER

Application No. 65230 Permit No. 47661.....  
IN NAME OF

 Primary  
 Suppl'

DARWIN & JEANNE SECORD

Surveyed JUNE 20 1988, by Z. F. SALEH.....