


T. 14S., R. 39E., W. M.

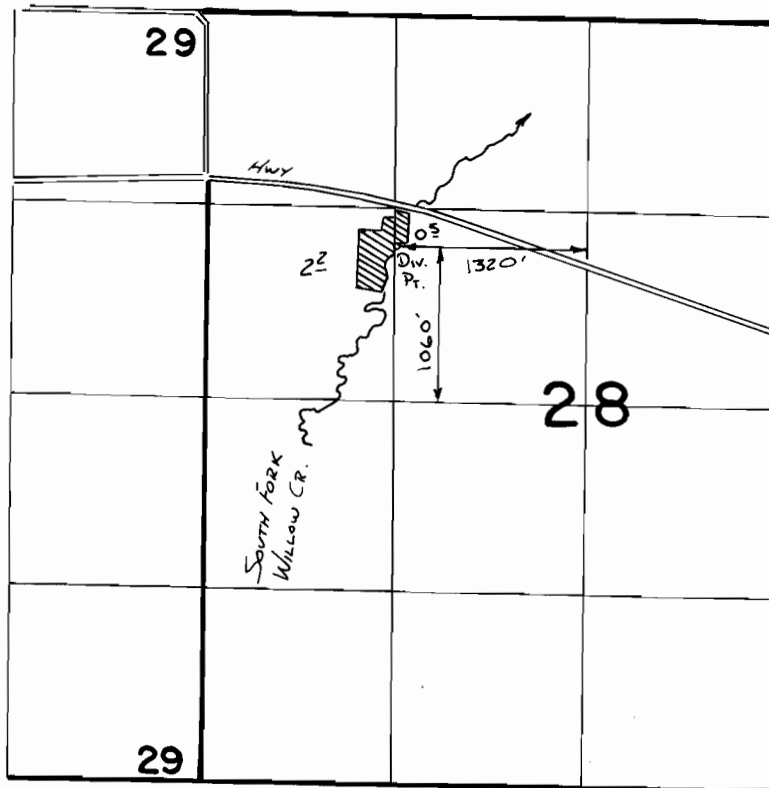

SCALE 1"=1320

**FINAL PROOF SURVEY**  
UNDER

Application No. **65232** Permit No. **47881**....  
IN NAME OF

.....**PRESTON FARBER**.....

Surveyed 5-23..... 1988, by V.H. Church.....