


# T. 26 S., R. 3 W., W.M.

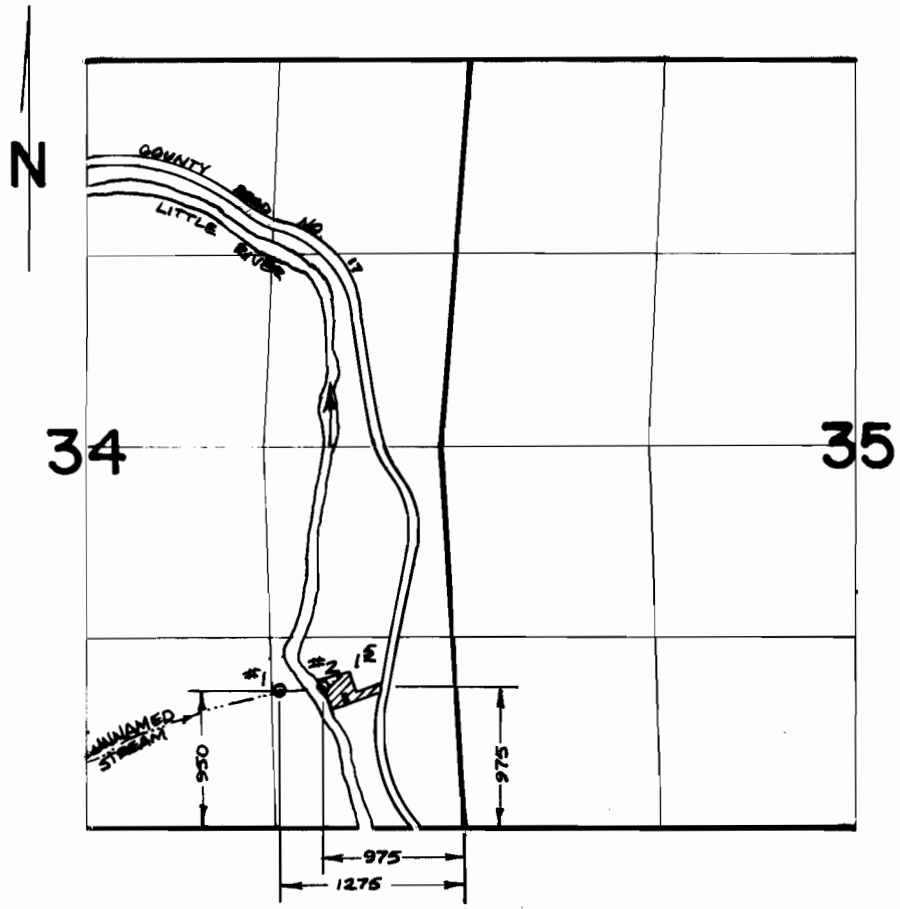

SCALE: 4" = 1 MILE

## FINAL PROOF SURVEY UNDER

Application No. ..65234.. Permit No. ....47663....  
IN NAME OF

.....**RUSSELL DEAN HENDRON**.....

Surveyed ..FEB..9,.. 19..88, by ..J.M..SCHMORDE..