


T. 38 S., R. 6 W., W. M.

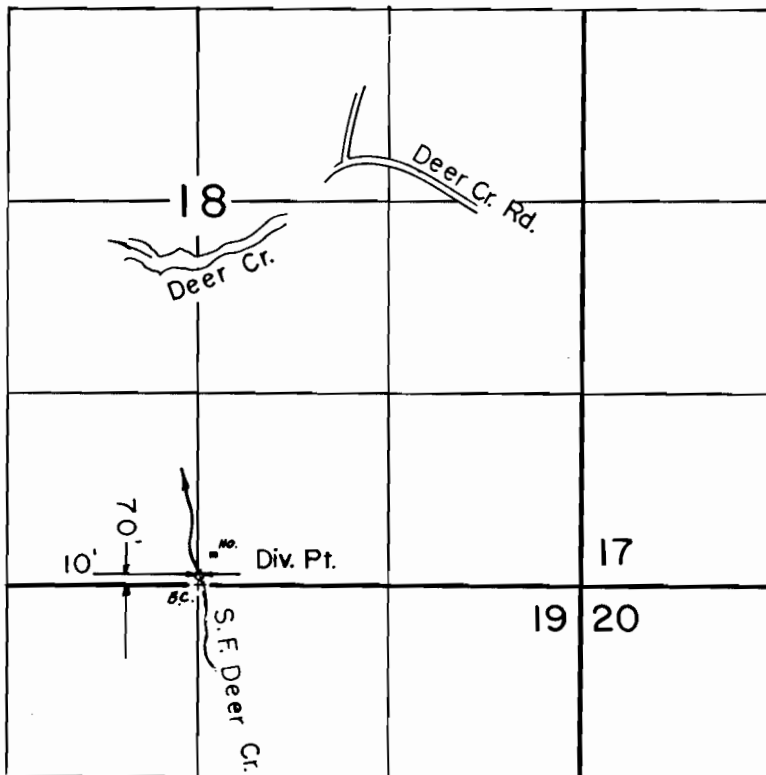

Scale: 1" = 1320'

**FINAL PROOF SURVEY**  
UNDER

Application No. 65313.. Permit No. 47692...  
IN NAME OF

.....RODNEY G. GOLDEN.....

Surveyed MAY 19.. 1988, by B. S. JAMES...