
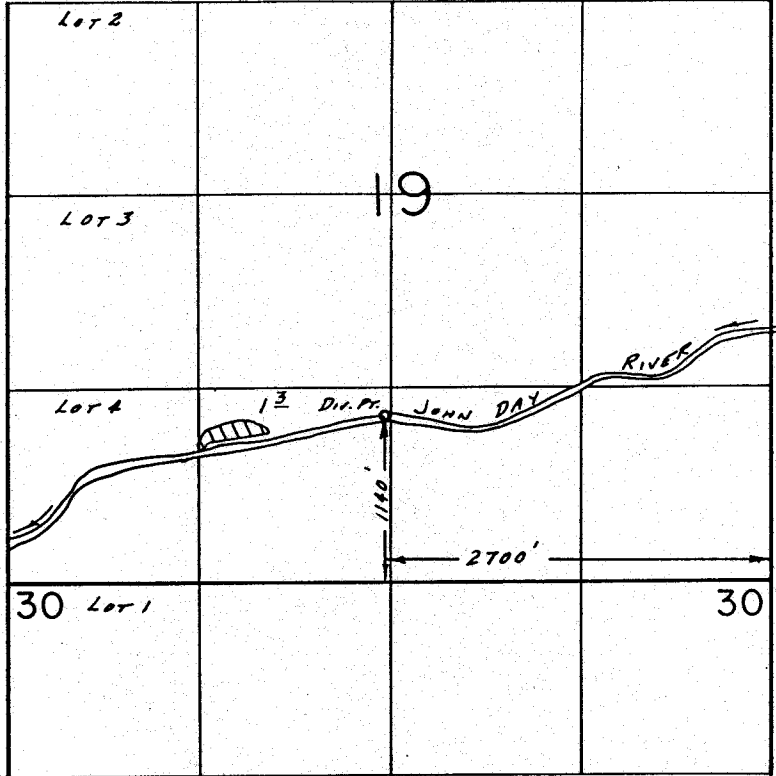


P-47699  
C-65527

T. 13S., R. 31E., W.M.

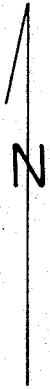

SCALE: 1" = 1320'

**FINAL PROOF SURVEY**  
UNDER

Application No. .65333. Permit No. .47699....  
IN NAME OF

.....JIM & MARILYN DERoy.....

Surveyed ..June.16.. 19.88., by V.L..CHURCH....