


T. 13S., R. 9E., W.M.

SECTION 10

LOT 13, TRACT H,
CAMP SHERMAN
SUMMER HOMES

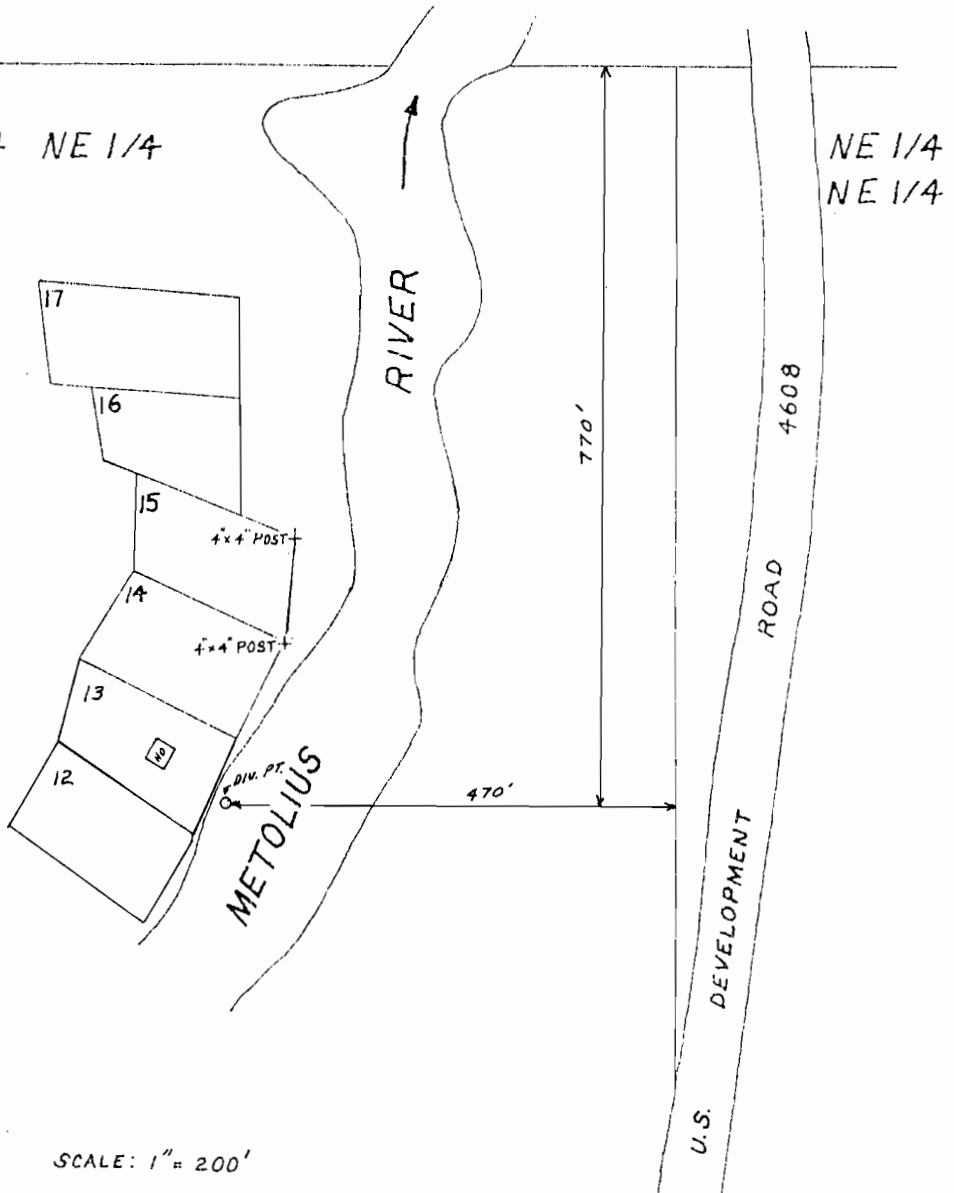

SCALE: 1" = 200'

FINAL PROOF SURVEY UNDER

Application No. 65392 Permit No. 47953
IN NAME OF

GEORGE E. WAKEFIELD

Surveyed MAY 19 1988, by B. BISHOP