


T. 12 S., R. 9 E., W.M.

SEC. 34

S 1/2 SE 1/4

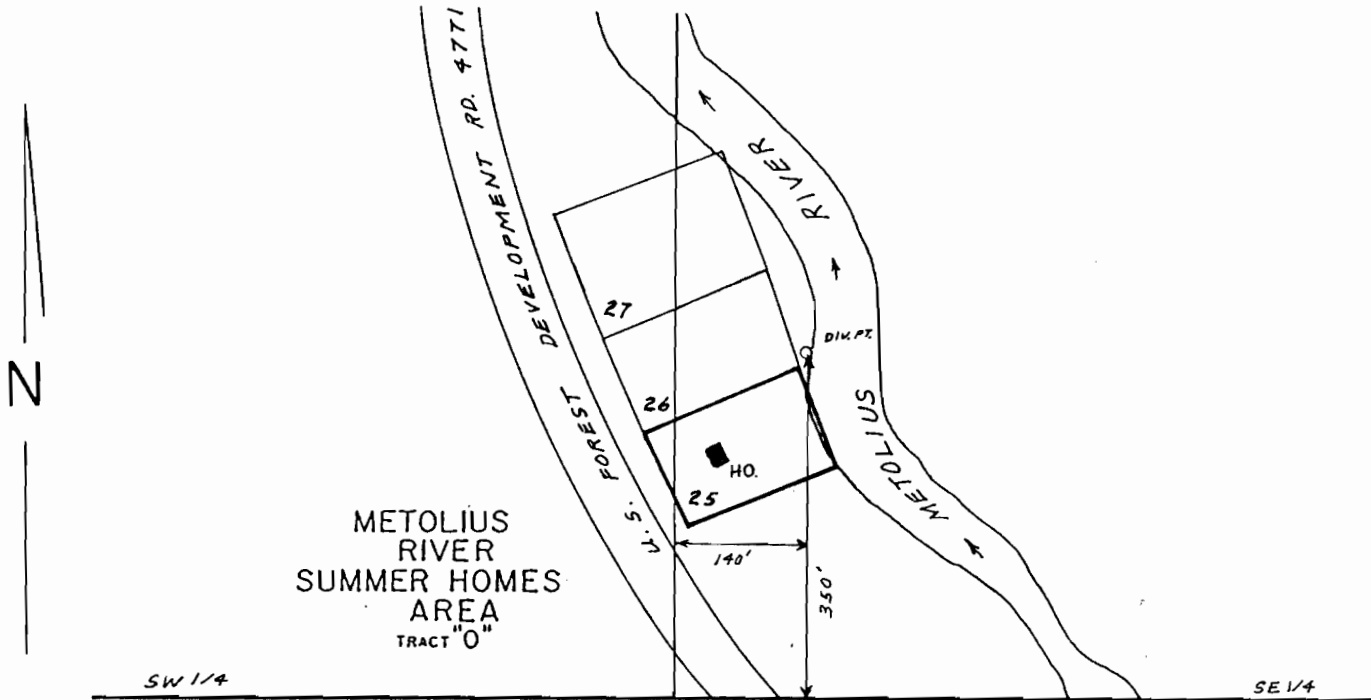

SCALE: 1" = 200'

FINAL PROOF SURVEY
UNDER

Application No. 65466. Permit No. 47954.....

IN NAME OF

GARY WRIGHT

Surveyed MAY 19... 19.88, by B. BISHOP.....