


P-48279
C-65533

T.13&14S., R.32E., W.M.

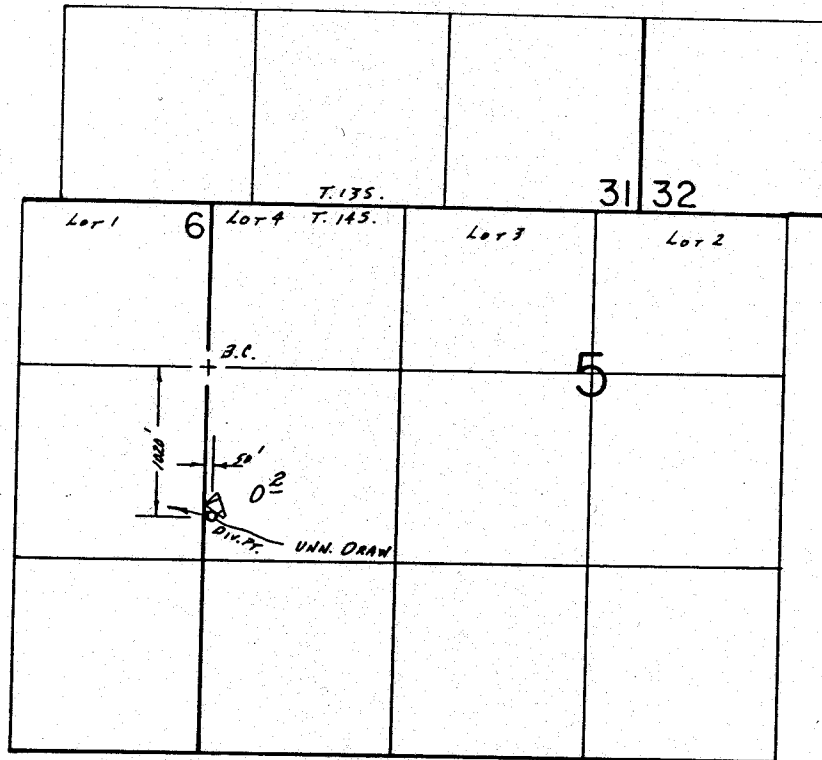

SCALE: 1" = 1320'

FINAL PROOF SURVEY
UNDER

Application No. 67722... Permit No. 48279.....
IN NAME OF

...DAVID L. & KARINE E. BARNTISH...

Surveyed June 21, 1988, by V.L. CHURCH.....

4/18/89
PTS BND