


T. 26 S., R. 7 W., W. M.  
SECTIONS 13 & 24

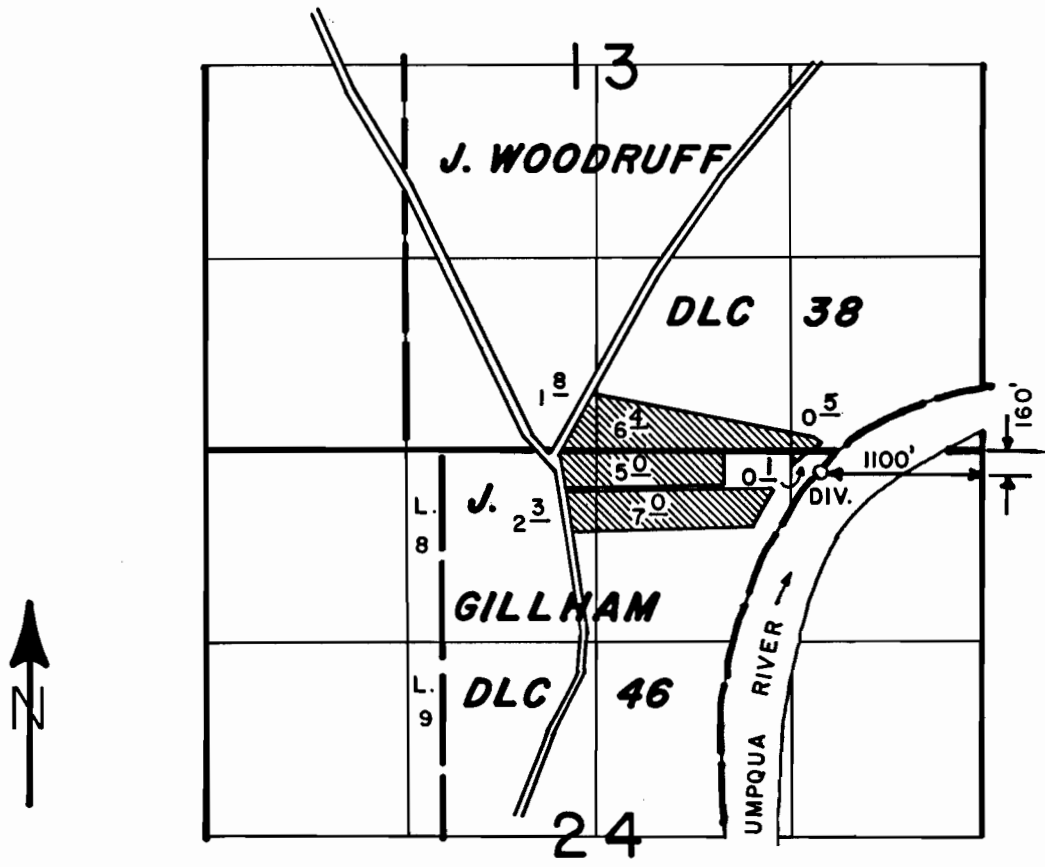

SCALE: 4" = 1 MILE

**FINAL PROOF SURVEY**  
UNDER

Application No. 67735 Permit No. 48215.....  
IN NAME OF

.....**ROBERT GORDON ILER**.....

Surveyed MAY 17... 1988., by J.M. SCHMORDE